

MISSISSIPPI DEPARTMENT OF NATURAL RESOURCES

Bureau of Land and Water Resources

Southport Mall

P.O. Box 10631

Jackson, Mississippi 39209

WATER WELL DRILLERS LOG

Wayne
L 2016
5-3-85

May 3 1985 date well completed
Gordon Drilling & Log firm name
Wayne county well located

LANDOWNER: Gene Mc Lain
At S Ry 135 E
Waynesboro ms
(mailing address)

WELL LOCATION:
sec. 15 T. 8 N. R. 9 E.
13 miles W of Waynesboro
(distance) (direction) (nearest town)

WELL PURPOSE: home
(home, irrigation, municipal, industrial)

WELL COMPLETION DATA:
(1) diameter (inches) 2'
(2) total depth (feet) 140'
(3) static water level (feet) 27 (below) above top of ground.
(4) casing P.V.C. 135'
(material) (depth)
2' if telescope see back.
(size)
(5) screen 5' 135'
(length) (depth to top)
2' half 5.5
(size) (material)
(6) pump merck
(HP) (yield gpm)
(type power)
(7) electric log _____
(yes or no)
(organization running log)
(8) how well bottom plugged
2' sand slash

description of formations encountered	from	to
clay	0	12
sand	12	18
clay	18	130
med. clean sand	130	140
slty. little shell in sand		
42' 1" PVC drage pipe		

RECEIVED


JUL 23 1985

Department of Natural Resources
Bureau of Land & Water Resources

DRILLERS REMARKS:

If well telescopes please sketch and show depths.

GROUND LEVEL

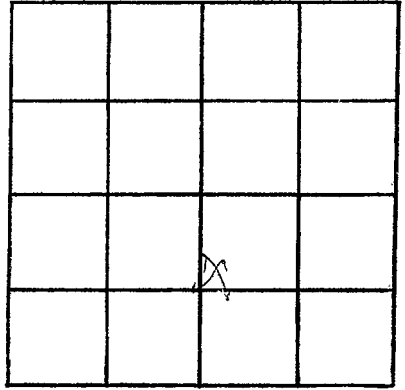

SECTION 15

Please indicate well location X.

ADDITIONAL INFORMATION

If more than one screen,
show locations of each on sketch.