

WAYNE

L 2005

10-5-78

MISSISSIPPI BOARD OF WATER COMMISSIONERS
416 North State Street
Jackson, Mississippi 39201

WATER WELL DRILLERS LOG

McILWAIN WATER WELL SERVICE

Wayne

date well completed

RI. firm name

county well located

WAYNESBORO MISS. 39367

LANDOWNER:

Jane Clark
Waynesboro
(mailing address)

description of formations encountered

from

to

Red Sandy Clay 0 8

WELL LOCATION:

sec. 8 T. 8 N R. 9 E

6 2 miles W of W. White
(distance) (direction) (nearest town)

Mixed Clay 08 12

SAND 12 18

WELL PURPOSE: none
(home, irrigation, municipal, industrial)

SAND & CLAY 18 35

WELL COMPLETION DATA:

(1) diameter (inches) 2"
(2) total depth (feet) 71'
(3) static water level (feet) 41' below top of ground

SAND 35 50

(4) casing PVC 106'
(material) (depth)

SAND & CLAY 50 58

2" if telescope see back.
(size)

COARSE SAND 58 71

(5) screen 5' 106'
(length) (depth to top)

2" PVC .008
(size) (material)

(6) pump 1 13
(HP) (yield gpm)

220 AC
(type power)

(7) electric log NO
(yes or no)

(organization running log)

(8) how well bottom plugged

DRILLERS REMARKS:


RECEIVED

OCT 26 1978

MISS. BD. OF WATER COMM.

If well telescopes please sketch and show depths.

GROUND LEVEL

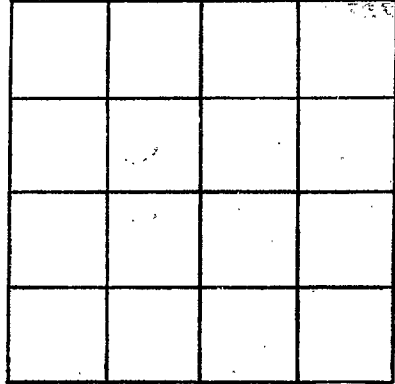

SECTION _____

Please indicate well location X.

ADDITIONAL INFORMATION

If more than one screen, show locations of each on sketch.