

MI

2-4-64

WATER WELL DRILLERS LOG

Date: Feb. 4, 1964, Driller: Porter Drilling Co. County: Wayne
 3P (Name)

(1) Owner of Land: Otto Davis
 (Name)
Rt 1 Hazenboro, Miss.
 (Address)
 (2) Location: SE 1/4, SE 1/4, Sec. 14 T8R8.
8 miles west of Hazenboro,
 (distance) (direction) (Nearest Town)
 (3) Topography: hilly
 (Hilly) (Flat) (Level)
 (4) Purpose of Well: domestic
 (Domestic Irrigation
 Municipal, Industrial, Other)


Description & Color of Materials Sand, Clay, Red Clay, Shell, etc.	Thick- ness Feet	Depth Feet
<u>red clay</u>	<u>10</u>	<u>10</u>
<u>course red sand</u>	<u>7</u>	<u>17</u>
<u>Chalk</u>	<u>8</u>	<u>25</u>
<u>fine red sand</u>	<u>10</u>	<u>35</u>
<u>sand & Chalk</u>	<u>29</u>	<u>64</u>
<u>Chalk</u>	<u>6</u>	<u>70</u>
<u>fine sand</u>	<u>9</u>	<u>79</u>
<u>course sand & pea gravel</u>	<u>6</u>	<u>85</u>
<u>fine sand</u>	<u>20</u>	<u>105</u>
<u>course sand & pea gravel</u>	<u>7</u>	<u>112</u>
<u>course sand</u>	<u>12</u>	<u>124</u>
<u>stopped while still in sand</u>		

Information upon completion of well:

(1) Diameter: 2" inches.
 (2) Total Depth: 124' feet.
 (3) Water Level: 80' feet below top of ground.
 (4) Cased to: 119', Size: 2"
 (5) Screen: Size: 1/4", Length: 5'
Johnson S.S
 (6) Were any formations sealed against pollution?
 _____ yes, X no.

If YES depth of formation _____
 Why _____

Drillers Remarks: _____

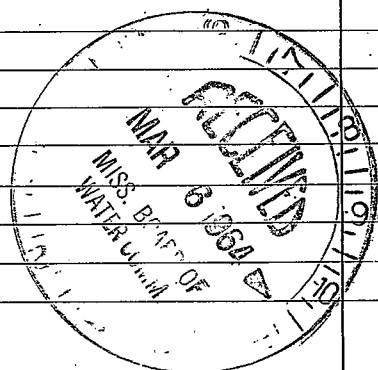

(Use Back Side)

Well No.

