

WAYNE MISSISSIPPI BOARD OF WATER COMMISSIONERS

M2

7-18-63

WATER WELL DRILLERS LOG

Date: July 18, 1963, Driller: Porter Drilling & Sps County Wayne  
(Name)


(1) Owner of Land: Berry Davis  
(Name)  
Rt 1 Magneshoro  
(Address)  
 (2) Location: SW 1/4, SE 1/4, Sec. 11 T8 R8,  
9 miles west, of Magneshoro  
(distance) (direction) (Nearest Town)  
 (3) Topography: Hilly  
(Hilly) (Flat) (Level)  
 (4) Purpose of Well: domestic  
(Domestic Irrigation Municipal, Industrial, Other)

Description & Color of Materials Sand, Clay, Red Clay, Shell, etc.	Thick- ness Feet	Depth Feet
<u>red sandy clay</u>	<u>8</u>	<u>8</u>
<u>red clay</u>	<u>7</u>	<u>15</u>
<u>sand &amp; chalk</u>	<u>15</u>	<u>30</u>
<u>red chalk</u>	<u>10</u>	<u>40</u>
<u>chalk &amp; sand</u>	<u>70</u>	<u>110</u>
<u>solidified red sand</u>		
<u>&amp; pea gravel</u>	<u>9</u>	<u>119</u>
<u>above white sand</u>		
<u>&amp; some pea gravel</u>	<u>13</u>	<u>132</u>
<u>stopped while still</u>		
<u>in sand</u>		

Information upon completion of well:

(1) Diameter 2" inches.  
 (2) Total Depth 132' feet.  
 (3) Water Level 78' feet below top of ground.  
 (4) Cased to 126', Size 2"  
 (5) Screen: Size 1/4", Length 5'  
Johnson S.S.  
 (6) Were any formations sealed against pollution?  
yes,  no.

If YES depth of formation \_\_\_\_\_  
 Why \_\_\_\_\_  
 Drillers Remarks: Jet pump 1/2 HP

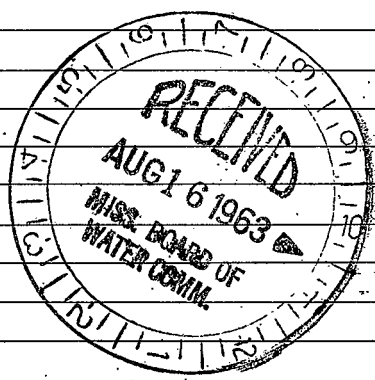

(Use Back Side)

Well No.

