

WAYNE MISSISSIPPI BOARD OF WATER COMMISSIONERS

M3

5-29-63

WATER WELL DRILLERS LOG

Date: May 29, 1963, Driller: Porter Drilling & Sup. Co. Wayne
 30 (Name)


(1) Owner of Land: E. C. Davis
 (Name)
At 1 Waynesboro, Miss
 (Address)
 (2) Location: NE 1/4, NW 1/4, Sec. 5 T8R8
10 miles west of Waynesboro
 (distance) (direction) (Nearest Town)
 (3) Topography: hilly
 (Hilly) (Flat) (Level)
 (4) Purpose of Well: domestic
 (Domestic Irrigation, Municipal, Industrial, Other)

Description & Color of Materials Sand, Clay, Red Clay, Shell, etc.	Thick- ness Feet	Depth Feet
deeper old well for	72'	
blue chalk	24	96'
fine sand	14	110
soft rock	4	114
chalk	8	122
sand & some chalk	38	160
course white sand	8	168
red sand	8	175
white med. clean sand	15	190
soft chalky sand	10	200
sand, light & chalk	15	215
med. sand	20	235
blue sand, lignite & blue soft chalk	25	260
thin rock		260
blue chalk	7	267
rock	4	271
blue chalk	15	286
strata of rock & chalk	14	300
blue chalk	39	339
reduced hole & set cas. at 339'		
rock sand	15	354
honeycomb rock	16	370
white chalk	7	377

Information upon completion of well:

(1) Diameter 2" inches.
 (2) Total Depth 377' feet.
 (3) Water Level 129' feet below top of ground.
 (4) Cased to 338 1/2', Size 2"
 (5) Screen: Size none Length _____
 (6) Were any formations sealed against pollution?
 _____ yes, X no.

If YES depth of formation _____
 Why _____
 Drillers Remarks: _____

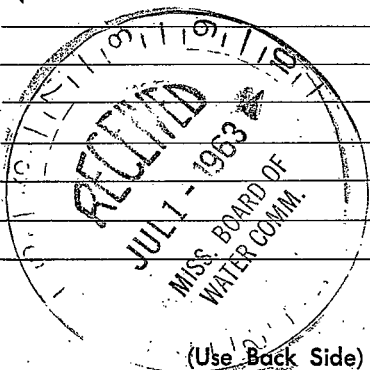

Well No.

