

WAYNE MISSISSIPPI BOARD OF WATER COMMISSIONERS

M4

9-7-63

WATER WELL DRILLERS LOG

Date: Sept 7, 1963, Driller: Porter Drilling & Log County Wayne
(Name)

(1) Owner of Land: Virgil Palmer
(Name)
At 1 Waynesboro Miss.
(Address)

(2) Location: NW 1/4, NE 1/4, Sec. 2 T8R8
6 miles west of Waynesboro,
(distance) (direction) (Nearest Town)

(3) Topography: hilly
(Hilly) (Flat) (Level)

(4) Purpose of Well: domestic
(Domestic Irrigation Municipal, Industrial, Other)

Description & Color of Materials Sand, Clay, Red Clay, Shell, etc.	Thick- ness Feet	Depth Feet
<u>red clay</u>	<u>18</u>	<u>18</u>
<u>sand & little chalk</u>	<u>44</u>	<u>62</u>
<u>soft chalk</u>	<u>15</u>	<u>77</u>
<u>sand rock</u>	<u>1</u>	<u>78</u>
<u>hard sand & pea gravel</u>	<u>4</u>	<u>82</u>
<u>sand</u>	<u>46</u>	<u>128</u>

Information upon completion of well:

(1) Diameter 2" inches.

(2) Total Depth 128' feet.

(3) Water Level 104' feet below top of ground.


(4) Cased to 122', Size 2"

(5) Screen: Size 1 1/4", Length 5'
Johnson S.S.

(6) Were any formations sealed against pollution?
 _____ yes, X no.

If YES depth of formation _____
 Why _____

Drillers Remarks: Jet pump 3/4 HP

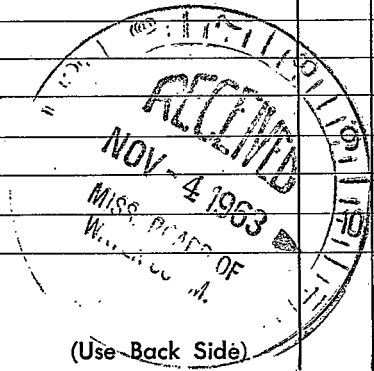

(Use Back Side)

Well No.

