

WAYNE MISSISSIPPI BOARD OF WATER COMMISSIONERS

M6

6-22-63

WATER WELL DRILLERS LOG

Date: June 22, 1963, Driller: Porter Drilling & Pump Co. County Wayne
(Name)

(1) Owner of Land: Pat Rawson
(Name)
Pat 1 Waynesboro
(Address)
 (2) Location: NE 1/4, NE 1/4, Sec 5 T8R8
10 1/2 miles west of Waynesboro
(distance) (direction) (Nearest Town)
 (3) Topography: hilly
(Hilly) (Flat) (Level)
 (4) Purpose of Well: domestic
(Domestic Irrigation Municipal, Industrial, Other)

Description & Color of Materials Sand, Clay, Red Clay, Shell, etc.	Thick- ness Feet	Depth Feet
red clay	8	8
chalk	7	15
sand	4	19
soft chalk	15	34
sand & chalk	10	44
sand	7	51
chalk	4	55
sand & chalk	13	68
clean white sand	17	85


Information upon completion of well:

(1) Diameter 2" inches.
 (2) Total Depth 85' feet.
 (3) Water Level 36' feet below top of ground.
 (4) Cased to 79', Size 2"
 (5) Screen: Size 1 1/4", Length 6'
80 ga
 (6) Were any formations sealed against pollution?
 _____ yes, X no.

If YES depth of formation _____

Why _____

Drillers Remarks: _____

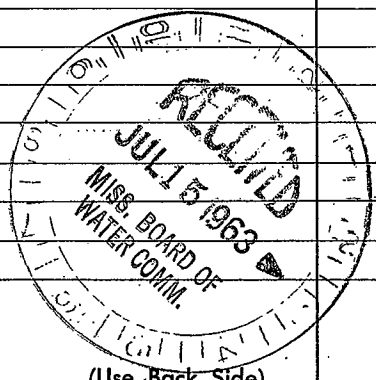

(Use Back Side)

Well No. _____

