

M8

8-12-63

WATER WELL DRILLERS LOG

Date: Aug 12, 1963, Driller: Porter Drilling & Supply Co County Wayne
 30 (Name)

(1) Owner of Land: Mrs Robert Busby
 (Name)
At 1 Haynesboro
 (Address)

(2) Location: NE 1/4, NE 1/4, Sec. 5 T8R8
9 miles west of Haynesboro
 (distance) (direction) (Nearest Town)

(3) Topography: Hilly
 (Hilly) (Flat) (Level)

(4) Purpose of Well: domestic
 (Domestic Irrigation
 Municipal, Industrial, Other)

Description & Color of Materials Sand, Clay, Red Clay, Shell, etc.	Thick- ness Feet	Depth Feet
<u>red clay</u>	<u>18</u>	<u>18'</u>
<u>chalk</u>	<u>37</u>	<u>55</u>
<u>fine sand & chalk</u>	<u>10</u>	<u>65</u>
<u>most part micaceous chalk</u>	<u>14</u>	<u>79</u>
<u>red sand</u>	<u>3</u>	<u>82</u>
<u>stopped on chalk</u>		

Information upon completion of well:

(1) Diameter 2'' inches.

(2) Total Depth 76' feet.

(3) Water Level 45 feet below top of ground.


(4) Cased to 64', Size 2''

(5) Screen: Size 1 1/2'', Length 12'

(6) Were any formations sealed against pollution?
 _____ yes, X no.

If YES depth of formation _____
 Why _____

Drillers Remarks: _____

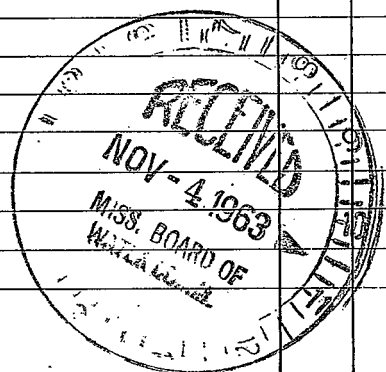

(Use Back Side)

Well No.

