

M9

10-6-64

WATER WELL DRILLERS LOG

Date: Oct 6, 1964, Driller: Porter Drilling & Pump Co. Wayne
 3P (Name)


(1) Owner of Land: Steve Mozingo
 (Name)
Rt 1 Waynesboro, Miss
 (Address)
 (2) Location: NW 1/4, SW 1/4, Sec. 1 T. 8. R. 8.
7 miles west of Waynesboro
 (distance) (direction) (Nearest Town)
 (3) Topography: Hilly
 (Hilly) (Flat) (Level)
 (4) Purpose of Well: domestic
 (Domestic Irrigation
 Municipal, Industrial, Other)

Description & Color of Materials Sand, Clay, Red Clay, Shell, etc.	Thick- ness Feet	Depth Feet
<u>red clay</u>	<u>12</u>	<u>12</u>
<u>fine sand</u>	<u>10</u>	<u>22</u>
<u>Chalk</u>	<u>28</u>	<u>50</u>
<u>pea gravel & sand</u>	<u>22</u>	<u>72</u>
<u>sand</u>	<u>6</u>	<u>78</u>
<u>Chalk</u>	<u>4</u>	<u>82</u>

Information upon completion of well:

(1) Diameter 2" inches.
 (2) Total Depth 77' feet.
 (3) Water Level 64' feet below top of ground.
 (4) Cased to 72', Size 2"
 (5) Screen: Size 1 1/4", Length 5'
Johnson S.S.
 (6) Were any formations sealed against pollution?
 _____ yes, X no.

If YES depth of formation _____
 Why _____
 Drillers Remarks: _____

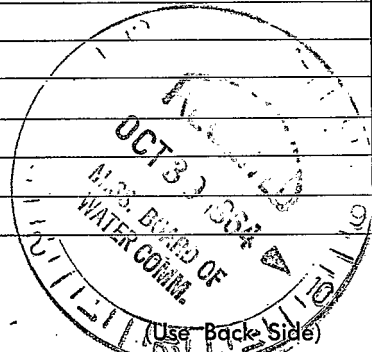

Well No.

