

Wayne
 Mill
 6-67
 3P

MISSISSIPPI
 BOARD OF WATER COMMISSIONERS
 416 North State Street
 Jackson, Mississippi 39201

WATER WELL DRILLERS LOG

June 23 1967 Booth Drilling & Pipe Wayne
 date well completed firm name county well located

LANDOWNER: Mrs Lizzie Cooley

description of formations encountered from to

Rt 1 Waynesboro
 (mailing address)

old well pulled and put deeper
 over white sand 63 69
 stop put while still in sand

WELL LOCATION:
 sec. 2 T. 8 (N) R. 8 (E)
8 miles west Waynesboro
 (distance) (direction) (nearest town)

WELL PURPOSE: home
 (home, irrigation, municipal, industrial)


- WELL COMPLETION DATA:
- (1) diameter (inches) 2"
 - (2) total depth (feet) 69'
 - (3) static water level (feet) 51' below above top of ground.
 - (4) casing steel, 63'
 (material) (depth)
2" if telescope see back.
 (size)
 - (5) screen 5', 64'
 (length) (depth to top)
1 1/4 7 gal Johnson S.S.
 (size) (material)
 - (6) pump 1/2, 5
 (HP) (yield gpm)
elec
 (type power)
 - (7) electric log no
 (yes or no)
 (organization running log)
 - (8) how well bottom plugged
flush screen

DRILLERS REMARKS:



If well telescopes please sketch and show depths.

GROUND LEVEL

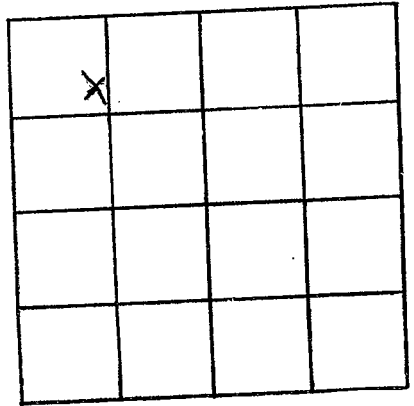

SECTION 2

Please indicate well location X.

ADDITIONAL INFORMATION

If more than one screen, show locations of each on sketch.