

WAYNE MISSISSIPPI BOARD OF WATER COMMISSIONERS

M/2

1-18-66

WATER WELL DRILLERS LOG

Date: Jan 18, 1966, Driller: Porter Drilling Co County Wayne
 3P (Name)

(1) Owner of Land: Scott Lindsey
 (Name)
Rt 1 Waynesboro, Miss
 (Address)
 (2) Location: NW 1/4, NE 1/4, Sec. 2 T8 R8
8 miles west of Waynesboro
 (distance) (direction) (Nearest Town)
 (3) Topography: Hilly
 (Hilly) (Flat) (Level)
 (4) Purpose of Well: Domestic
 (Domestic Irrigation
 Municipal, Industrial, Other)


Description & Color of Materials Sand, Clay, Red Clay, Shell, etc.	Thick- ness Feet	Depth Feet
<u>red clay</u>	<u>12</u>	<u>12</u>
<u>sand</u>	<u>18</u>	<u>30</u>
<u>sand & chalk</u>	<u>29</u>	<u>59</u>
<u>mostly chalk</u>	<u>8</u>	<u>66</u>
<u>covered red sand</u>		
<u>& some pea gravel</u>	<u>25</u>	<u>91</u>
<u>stopped while stuck</u>		
<u>in coarse red sand</u>		

Information upon completion of well:

(1) Diameter 2" inches.
 (2) Total Depth 91' feet.
 (3) Water Level 70' feet below top of ground.
 (4) Cased to 84', Size 2" copper.
 (5) Screen: Size 1 1/4", Length 5'.
Johnson S.S. 8 slot
 (6) Were there any formations sealed against pollution?

yes, X no.

If YES depth of formation _____
 Why _____
 Drillers Remarks: _____

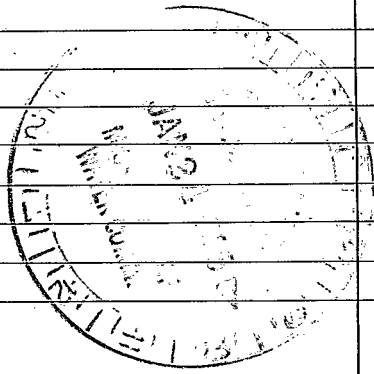

(Use Back Side)

Well No.

