

WAYNE MISSISSIPPI BOARD OF WATER COMMISSIONERS

MB

3-24-65

WATER WELL DRILLERS LOG

Date: March 24, 1965, Driller: Portwood Drilling & Pipe County Wayne  
 3P (Name)

(1) Owner of Land: Sam Finer  
 (Name)  
At 1 Haynesboro, Miss.  
 (Address)  
 (2) Location: SE 1/4, SW 1/4, Sec. 2 T. 8 R. 8  
7 miles west of Haynesboro  
 (distance) (direction) (Nearest Town)  
 (3) Topography: hilly  
 (Hilly) (Flat) (Level)  
 (4) Purpose of Well: domestic  
 (Domestic Irrigation  
 Municipal, Industrial, Other)


| Description & Color of Materials<br>Sand, Clay, Red Clay, Shell, etc. | Thick-<br>ness<br>Feet | Depth<br>Feet |
|---|------------------------|---------------|
| <u>red clay</u>   | <u>4</u>               | <u>4</u>      |
| <u>sand &amp; chals</u>   | <u>29</u>              | <u>33</u>     |
| <u>chals</u>  | <u>22</u>              | <u>55</u>     |
| <u>thin sand rock</u>   |                        | <u>55</u>     |
| <u>course red sand</u>  | <u>29</u>              | <u>84</u>     |
| <u>med course white sand</u>  | <u>5</u>               | <u>89</u>     |

Information upon completion of well:

(1) Diameter 2" inches.  
 (2) Total Depth 89' feet.  
 (3) Water Level 59' feet below top of ground.  
 (4) Cased to 84', Size 2"  
 (5) Screen: Size 1/4", Length 5'  
8 slot S.S.  
 (6) Were any formations sealed against pollution?

no yes, 1 no.

If YES depth of formation \_\_\_\_\_  
 Why \_\_\_\_\_  
 Drillers Remarks: \_\_\_\_\_

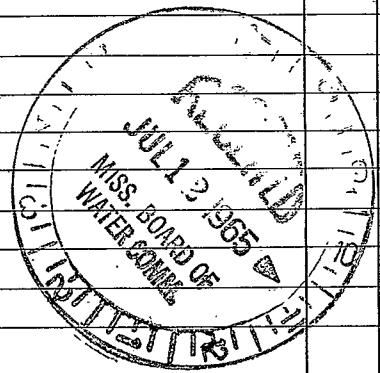

(Use Back Side)

Well No.

