

WAYNE MISSISSIPPI BOARD OF WATER COMMISSIONERS

M18

12-8-65

WATER WELL DRILLERS LOG


Date: Dec 8, 1965, Driller: Porter Drilling & Log County, Wayne  
 3P (Name)

	Description & Color of Materials Sand, Clay, Red Clay, Shell, etc.	Thick- ness Feet	Depth Feet
(1) Owner of Land: <u>Maynard Creek Assoc of Prop</u> (Name) <u>Rt 1 Waynesboro, Miss</u> (Address)	<u>red clay</u>	<u>20</u>	<u>20</u>
(2) Location: <u>NE 1/4, NE 1/4, Sec. 3 T8 R8</u> <u>8</u> miles <u>west</u> , of <u>Waynesboro</u> (distance) (direction) (Nearest Town)	<u>red sand</u> <u>thin rock</u> <u>Chalk</u>	<u>18</u> <u>24</u>	<u>38</u> <u>62</u>
(3) Topography: <u>hilly</u> (Hilly) (Flat) (Level)	<u>fine sand &amp; chalk</u>	<u>18</u>	<u>80</u>
(4) Purpose of Well: <u>domestic</u> (Domestic Irrigation Municipal, Industrial, Other)	<u>fine red sand</u> <u>med red sand</u>	<u>9</u> <u>11</u>	<u>89</u> <u>100</u>
	<u>med to coarse white</u> <u>sand</u>	<u>15</u>	<u>115</u>
	<u>stagnant white steel</u> <u>in coarse sand</u>		

Information upon completion of well:

- (1) Diameter 2" inches.
- (2) Total Depth 115' feet.
- (3) Water Level 60' feet below top of ground.
- (4) Cased to 105', Size 2"
- (5) Screen: Size 1 1/4", Length 3'  
8 slot Johnson S.S.
- (6) Were any formations sealed against pollution?  
 yes,  no.

If YES depth of formation \_\_\_\_\_  
 Why \_\_\_\_\_  
 Drillers Remarks: \_\_\_\_\_

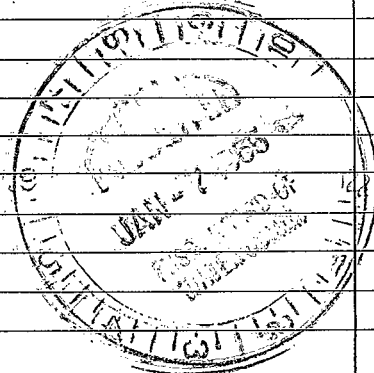

(Use Back Side)

Well No.

