

WAYNE MISSISSIPPI BOARD OF WATER COMMISSIONERS

M19

7-14-62

WATER WELL DRILLERS LOG

Date: July 14, 1962, Driller: Porter Drilling & Pump County: Wayne
(Name)

(1) Owner of Land	Description & Color of Materials Sand, Clay, Red Clay, Shell, etc.	Thick- ness Feet	Depth Feet
<u>James R. Biggley</u> <small>(Name)</small>	<u>med clay</u>	<u>22</u>	<u>22</u>
<u>Rt 1 Haynesboro, Miss</u> <small>(Address)</small>	<u>mixed sand</u>	<u>17</u>	<u>39</u>
(2) Location: <u>NW 1/4, NE 1/4, Sec. 3 T 8 R 8</u>	<u>white chert</u>	<u>12</u>	<u>51</u>
<u>8 miles west</u> of <u>Haynesboro</u> <small>(distance) (direction) (Nearest Town)</small>	<u>fine sand & chalk</u>	<u>33</u>	<u>84</u>
(3) Topography: <u>Hilly</u> <small>(Hilly) (Flat) (Level)</small>	<u>med. sand</u>	<u>12</u>	<u>96</u>
(4) Purpose of Well: <u>domestic</u> <small>(Domestic Irrigation Municipal, Industrial, Other)</small>			

Information upon completion of well:


- (1) Diameter 2" inches.
- (2) Total Depth 96' feet.
- (3) Water Level 51 feet below top of ground.
- (4) Cased to 90', Size 2"
- (5) Screen: Size 1/4", Length 6'
- (6) Were any formations sealed against pollution?

yes, no.

If YES depth of formation _____

Why _____

Drillers Remarks: _____

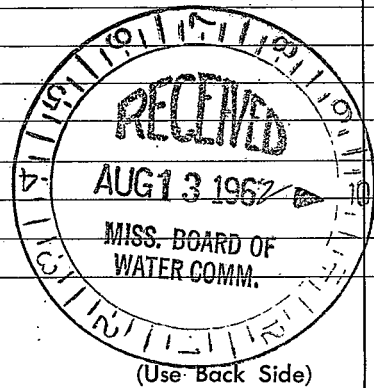

Well No.

[The page contains extremely faint and illegible text, likely bleed-through from the reverse side of the document. No specific words or phrases can be discerned.]