

WAYNE

M 20

7-16-66

MISSISSIPPI BOARD OF WATER COMMISSIONERS

WATER WELL DRILLERS LOG

Date: July 16, 1966, Driller: Porter Drilling & Supply Co. Wayne
3P (Name)

(1) Owner of Land: J. T. Rigney
(Name)
Rt 1 Waynesboro, Miss
(Address)

(2) Location: NW 1/4, NE 1/4, Sec. 3 T 8 R 8
8 miles west of Waynesboro
(distance) (direction) (Nearest Town)

(3) Topography: hilly
(Hilly) (Flat) (Level)

(4) Purpose of Well: domestic
(Domestic Irrigation
Municipal, Industrial, Other)

Description & Color of Materials Sand, Clay, Red Clay, Shell, etc.	Thick- ness Feet	Depth Feet
red clay	8	8
chalk	10	18
sand	20	38
chalk	25	63
chalk & sand	30	93
fine sand	17	110
coarse red sand & pea gravel	20	130
coarse red sand	48	178
blue chalk	3	181
blue sand	2	183
blue chalk	37	220
chalk & sand	9	229
rock 2'	2	231
blue chalk	14	245
rock stratum	18	263
blue chalk	42	305
honey comb rock Vicksburg Form.	25	330

Information upon completion of well:

(1) Diameter 2" inches.

(2) Total Depth 330' feet.

(3) Water Level 128' feet below top of ground.

(4) Cased to 305 1/2', Size 2"


(5) Screen: Size none, Length _____

(6) Were any formations sealed against pollution?
_____ yes, no.

If YES depth of formation _____

Why _____

Drillers Remarks: _____

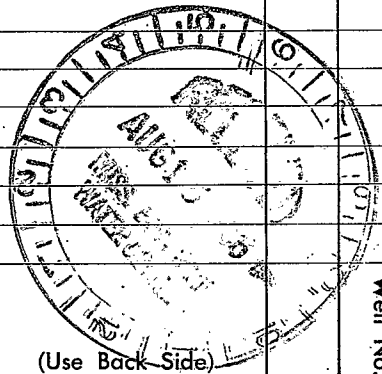

Well No.

(Use Back Side)

