

Wayne
M23
9-67
3P
9.13

MISSISSIPPI
BOARD OF WATER COMMISSIONERS
416 North State Street
Jackson, Mississippi 39201

WATER WELL DRILLERS LOG

date well completed 19 67 Royle West firm name Wayne county well located

LANDOWNER: A. L. Clay

description of formations encountered

from to

Rt 1
Waynesboro Miss
(mailing address)

<u>Red Clay</u>	<u>0</u>	<u>20</u>
<u>Sandy Clay</u>	<u>20</u>	<u>76</u>
<u>Sand</u>	<u>76</u>	<u>93</u>

WELL LOCATION:

sec 4 T 8 N R 18 E
S W
10 miles W of Waynesboro
(distance) (direction) (nearest town)

WELL PURPOSE: home
(home, irrigation, municipal, industrial)

WELL COMPLETION DATA:

(1) diameter (inches) 2
(2) total depth (feet) 93
(3) static water level (feet) 30 ~~below~~ above top of ground.

(4) casing Galv 88
(material) (depth)

5 88
(size) (depth to top)

(5) screen 14 St Steel
(size) (material)

(6) pump 1/2 4
(HP) (yield gpm)


Miss power
(type power)

(7) electric log no
(yes or no)

(organization running log)

(8) how well bottom plugged wash

DRILLERS REMARKS:

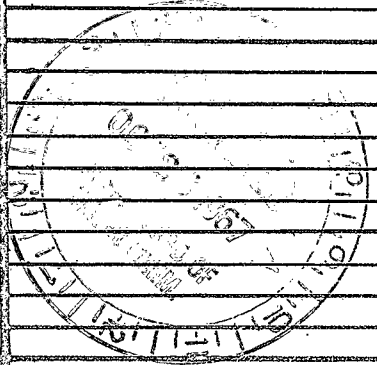

If well telescopes please sketch and show depths.

GROUND LEVEL

	X		

SECTION 4

Please indicate well location X.

ADDITIONAL INFORMATION

If more than one screen, show locations of each on sketch.