

WAYNE MISSISSIPPI BOARD OF WATER COMMISSIONERS

M 25

8-29-62

WATER WELL DRILLERS LOG


Date: Aug 29, 1962, Driller: Porter Drilling & Pipe County Wayne
 3P (Name)

(1) Owner of Land: <u>Cooley Butane Co</u> (Name)	Description & Color of Materials Sand, Clay, Red Clay, Shell, etc.	Thick- ness Feet	Depth Feet
<u>Qt 1 Waynesboro, Miss.</u> (Address)	<u>red clay</u>	<u>15</u>	<u>15</u>
(2) Location: <u>NW 1/4, NE 1/4, Sec. 4 T 8 R 2</u>	<u>white chalk</u>	<u>10</u>	<u>25</u>
<u>8</u> miles <u>west</u> , of <u>Waynesboro</u> (distance) (direction) (Nearest Town)	<u>med. sand</u>	<u>20</u>	<u>45</u>
(3) Topography: <u>hilly</u> (Hilly) (Flat) (Level)	<u>white chalk</u>	<u>10</u>	<u>55</u>
(4) Purpose of Well: <u>Commercial</u> (Domestic Irrigation Municipal, Industrial, Other)	<u>course sand</u>	<u>25</u>	<u>80</u>
	<u>stopped on chalk &</u>		
	<u>fine sand</u>		

Information upon completion of well:

- (1) Diameter 4" inches.
- (2) Total Depth 80' feet.
- (3) Water Level 38 feet below top of ground.
- (4) Cased to 67', Size 4"
- (5) Screen: Size 3/8", Length 15'
- (6) Were any formations sealed against pollution?
with Cook brass slotted
with bail bottom & lead seal
 _____ yes, X no.

If YES depth of formation _____
 Why _____
 Drillers Remarks: _____

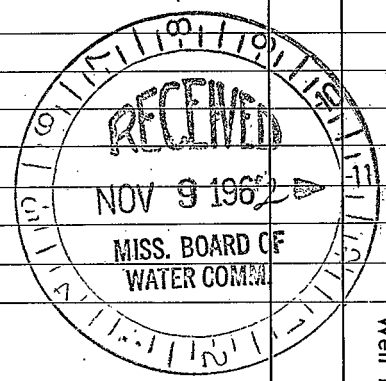

(Use Back Side)

Well No.

