

WAYNE MISSISSIPPI BOARD OF WATER COMMISSIONERS

M 27

3-2-61

WATER WELL DRILLERS LOG

M -300


Date: March 2, 1961, Driller: D. N. Porter in County Wayne
 3P (Name)

(1) Owner of Land:	Description & Color of Materials Sand, Clay, Red Clay, Shell, etc.	Thick- ness Feet	Depth Feet
(Name) <u>Trinity Baptist Church</u> (Address) <u>Rt 1 Nagsboro, Miss</u>	<u>clay</u>	<u>20</u>	<u>21</u>
(2) Location: <u>NE 1/4, NW 1/4, Sec. 7, T 8 R 2</u>	<u>chert</u>	<u>40</u>	<u>60</u>
<u>9</u> miles <u>west</u> , of <u>Nagsboro</u> (distance) (direction) (Nearest Town)	<u>sand & chert</u>	<u>18</u>	<u>78</u>
(3) Topography: <u>hilly</u>	<u>sand</u>	<u>7</u>	<u>85</u>
(4) Purpose of Well: <u>domestic</u> (Domestic Irrigation Municipal, Industrial, Other)	<u>stop on chert</u>		

Information upon completion of well:

- (1) Diameter 2" inches.
- (2) Total Depth 85' feet.
- (3) Water Level 26' feet below top of ground.
- (4) Cased to 72', Size 2"
- (5) Screen: Size 1/4", Length 6'
60 ga
- (6) Were any formations sealed against pollution?
yes, no.

If YES depth of formation _____
 Why _____
 Drillers Remarks: _____

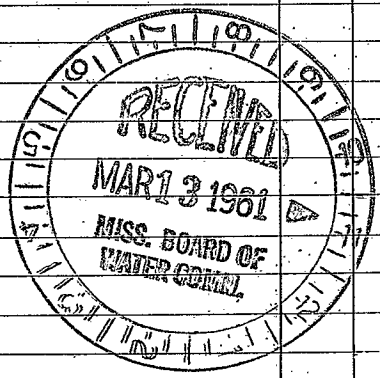

(Use Back Side)

