

Wayne  
M 30  
10-66

MISSISSIPPI BOARD OF WATER COMMISSIONERS

WATER WELL DRILLERS LOG

Date: Oct 13, 1966, Driller: Parton Drilling Co Wayne County  
30 (Name)

(1) Owner of Land: Messias Cooley  
(Name)  
Box 1 Waynesboro, Miss  
(Address)  
(2) Location: NW 1/4, NE 1/4, Sec. 5 T8R8  
10 miles west of Waynesboro  
(distance) (direction) (Nearest Town)  
(3) Topography: Hilly  
(Hilly) (Flat) (Level)  
(4) Purpose of Well: domestic  
(Domestic Irrigation  
Municipal, Industrial, Other)


Description & Color of Materials Sand, Clay, Red Clay, Shell, etc.	Thick- ness Feet	Depth Feet
<u>red clay</u>	<u>10</u>	<u>10</u>
<u>sand &amp; chalk</u>	<u>8</u>	<u>18</u>
<u>blue chalk</u>	<u>32</u>	<u>50</u>
<u>white sand</u>	<u>23</u>	<u>73</u>
<u>yellow sand</u>	<u>3</u>	<u>76</u>
<u>chalk</u>	<u>1</u>	<u>77</u>

Information upon completion of well:

(1) Diameter 2" inches.  
(2) Total Depth 77' feet.  
(3) Water Level 27' feet below top of ground.  
(4) Cased to 67', Size 2"  
(5) Screen: Size 1 1/4", Length 5'  
6 slot Johnson S.S.  
(6) Were any formations sealed against pollution?  
no

If YES depth of formation \_\_\_\_\_  
Why \_\_\_\_\_

Drillers Remarks: \_\_\_\_\_

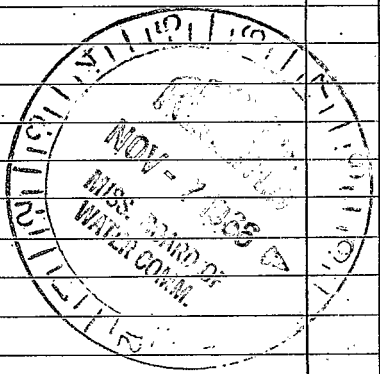

(Use Back Side)

Well No.

