

M31
7-5-62

WATER WELL DRILLERS LOG

Date: July 5, 1962, Driller: Porter Drilling & Sup. County Wayne
(Name)

	Description & Color of Materials Sand, Clay, Red Clay, Shell, etc.	Thick- ness Feet	Depth Feet
(1) Owner of Land: <u>R. T. Busby</u> (Name)	<u>red clay</u>	<u>6</u>	<u>6</u>
<u>Rt 1 Waynesboro Miss.</u> (Address)	<u>white chals</u>	<u>28</u>	<u>32</u>
(2) Location: <u>SW 1/4, SW 1/4, Sec. 7 T8R8</u> <u>12 miles west</u> of <u>Waynesboro</u> (distance) (direction) (Nearest Town)	<u>sand mixed with mucky chals</u>	<u>12</u>	<u>44'</u>
(3) Topography: <u>hilly</u> (Hilly) (Flat) (Level)			
(4) Purpose of Well: <u>domestic</u> (Domestic Irrigation Municipal, Industrial, Other)			


Information upon completion of well:

- (1) Diameter 1 1/4" inches.
- (2) Total Depth 40' feet.
- (3) Water Level 12 feet below top of ground.
- (4) Cased to 37, Size 1 1/4
- (5) Screen: Size 1 1/4, Length 3'
- (6) Were any formations sealed against pollution?
_____ yes, _____ no.

If YES depth of formation _____

Why _____

Drillers Remarks: _____

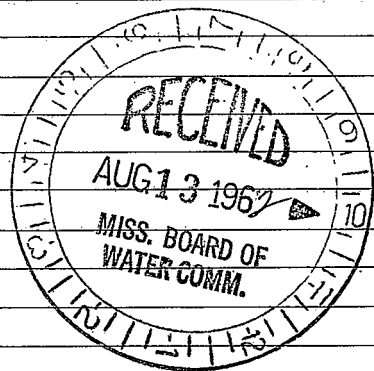

(Use Back Side)

Well No.

