

Wayne
M32
3-67

MISSISSIPPI
BOARD OF WATER COMMISSIONERS
416 North State Street
Jackson, Mississippi 39201

WATER WELL DRILLERS LOG

March 16 1967 Porter Drilling & Log Wayne
date well completed 3P firm name county well located


LANDOWNER:
Charley Pitts
211 Haynesboro Miss
(mailing address)

WELL LOCATION:
sec. 10 T. 8 N R. 8 E
S W
9 miles west of Haynesboro
(distance) (direction) (nearest town)

WELL PURPOSE: home
(home, irrigation, municipal, industrial)

WELL COMPLETION DATA:
(1) diameter (inches) 2"
(2) total depth (feet) 138'
(3) static water level (feet) 105' below above top of ground.
(4) casing galv. steel, 126'
(material) (depth)
2" if telescope see back.
(size)
(5) screen 5', 128'
(length) (depth to top)
1/4", S.S.
(size) (material)
(6) pump 3/4, 3 1/2
(HP) (yield gpm)
elec
(type power)
(7) electric log no
(yes or no)
(organization running log)
(8) how well bottom plugged
1 1/2 galv

description of formations encountered	from to	
<u>red clay sand</u>	<u>0</u>	<u>20</u>
<u>chalk & sand</u>	<u>20</u>	<u>79</u>
<u>thin rock</u>		<u>79</u>
<u>mostly chalk</u>	<u>79</u>	<u>107</u>
<u>med. gr. silt sand</u>	<u>107</u>	<u>118</u>
<u>Coire</u>	<u>118</u>	<u>124</u>
<u>med. sand slightly red</u>	<u>124</u>	<u>132</u>
<u>med. fine sand</u>	<u>132</u>	<u>138</u>
<u>stagnant white silt in sand</u>		

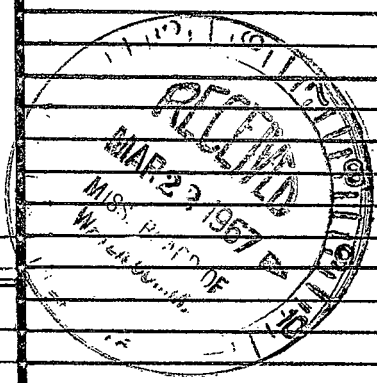

DRILLERS REMARKS:

If well telescopes please sketch and show depths.

GROUND LEVEL

X			

SECTION 10

Please indicate well location X.

ADDITIONAL INFORMATION

If more than one screen, show locations of each on sketch.