

WAYNE
M33

MISSISSIPPI BOARD OF WATER COMMISSIONERS

6-14-66

WATER WELL DRILLERS LOG

Date: June 14, 1966, Driller: Porter Drilling Co. County: Wayne
(Name)

(1) Owner of Land: Dave Kelley
(Name)
Rt 1 Waynesboro, Miss
(Address)

(2) Location: SE 1/4, NW 1/4, Sec. 10 T8R8
9 miles west of Waynesboro
(distance) (direction) (Nearest Town)

(3) Topography: hilly
(Hilly) (Flat) (Level)

(4) Purpose of Well: domestic
(Domestic Irrigation
Municipal, Industrial, Other)

Description & Color of Materials Sand, Clay, Red Clay, Shell, etc.	Thick- ness Feet	Depth Feet
<u>red clay</u>	<u>12</u>	<u>12</u>
<u>blue chalk</u>	<u>7</u>	<u>19</u>
<u>sand</u>	<u>11</u>	<u>30</u>
<u>chalk</u>	<u>10</u>	<u>40</u>
<u>rock</u>	<u>1</u>	<u>41</u>
<u>chalk</u>	<u>3</u>	<u>44</u>
<u>rock</u>	<u>1</u>	<u>45</u>
<u>orange red sand</u>	<u>17</u>	<u>62</u>
<u>fine "</u>	<u>10</u>	<u>72</u>
<u>Chalk & sand</u>	<u>20</u>	<u>92</u>
<u>red sand</u>	<u>23</u>	<u>115</u>
<u>red fine clean sand</u>	<u>7</u>	<u>122</u>
<u>fine sand mixed</u>		
<u>with gravel</u>	<u>4</u>	<u>126</u>

Information upon completion of well:

(1) Diameter 2" inches,

(2) Total Depth 126 feet.

(3) Water Level 88' feet below top of ground.

(4) Cased to 119 1/2', Size 2"


(5) Screen: Size 1 1/4", Length 5'
Johnson S.S. 6 slot

(6) Were any formations sealed against pollution?
no.

If YES depth of formation _____

Why _____

Drillers Remarks: _____

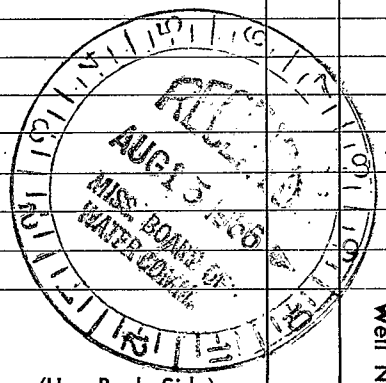

(Use Back Side)

Well No.

