

WAYNE MISSISSIPPI BOARD OF WATER COMMISSIONERS

M34

5-29-65

WATER WELL DRILLERS LOG

Date: May 29, 1965, Driller: Porter Drilling Shop County: Wayne
(Name)


(1) Owner of Land: Robert Williams
(Name)
Attn Wynneboro, Miss
(Address)
 (2) Location: NE 1/4, NW 1/4, Sec. 11 T8R8
7 miles west, of Wynneboro
(distance) (direction) (Nearest Town)
 (3) Topography: hilly
(Hilly) (Flat) (Level)
 (4) Purpose of Well: domestic
(Domestic Irrigation Municipal, Industrial, Other)

Description & Color of Materials Sand, Clay, Red Clay, Shell, etc.	Thick-ness Feet	Depth Feet
<u>red clay</u>	<u>10</u>	<u>10</u>
<u>sand</u>	<u>25</u>	<u>35</u>
<u>chalk</u>	<u>5</u>	<u>40</u>
<u>sanit</u>	<u>51</u>	<u>91</u>
<u>stagnant white</u>		
<u>still in sand</u>		

Information upon completion of well:

(1) Diameter 2" inches.
 (2) Total Depth 86' feet.
 (3) Water Level 57' feet below top of ground.
 (4) Cased to 81', Size 2"
 (5) Screen: Size 1 1/4", Length 5'
10 slot Johnson S. S.
 (6) Were any formations sealed against pollution?
 _____ yes, X no.

If YES depth of formation _____
 Why _____
 Drillers Remarks: _____

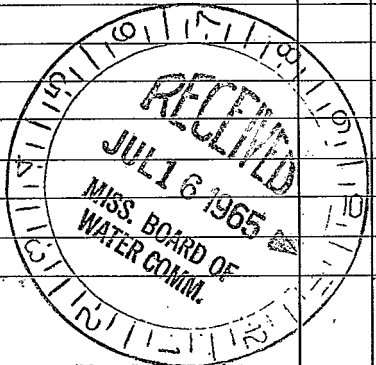

(Use Back Side)

Well No.

