

WAYNE MISSISSIPPI BOARD OF WATER COMMISSIONERS

M36

5-21-65

WATER WELL DRILLERS LOG

Date: May 21, 1965, Driller: Porter Drilling & Supply County Wayne
 (Name)
 3P

(1) Owner of Land	Description & Color of Materials Sand, Clay, Red Clay, Shell, etc.	Thick- ness Feet	Depth Feet
<u>Dr Newton Cooley</u> (Name)	<u>red clay</u>	<u>6</u>	<u>6</u>
<u>Rt 1 Waynesboro, Miss</u> (Address)	<u>sand</u>	<u>17</u>	<u>23</u>
(2) Location: <u>SW 1/4, NE 1/4, Sec. 11 T8 R8</u>	<u>rock</u>	<u>1</u>	<u>24</u>
<u>8</u> miles <u>west</u> , of <u>Waynesboro</u> (distance) (direction) (Nearest Town)	<u>sand</u>	<u>2</u>	<u>26</u>
(3) Topography: <u>Hilly</u> (Hilly) (Flat) (Level)	<u>Chalk</u>	<u>15</u>	<u>41</u>
(4) Purpose of Well: <u>domestic</u> (Domestic Irrigation Municipal, Industrial, Other).	<u>fine to med. sand</u>	<u>28</u>	<u>69</u>
	<u>course sand & peagavel</u>	<u>11</u>	<u>80</u>
	<u>" " " large</u>	<u>10</u>	<u>90</u>
	<u>course to med sand</u>	<u>15</u>	<u>105</u>
	<u>thin rock</u>		<u>105</u>
	<u>Chalk</u>	<u>7</u>	<u>112</u>
	<u>med course sand</u>	<u>8</u>	<u>120</u>
	<u>stagnant white stiff</u>		
	<u>id sand</u>		


Information upon completion of well:

- (1) Diameter 2" inches.
- (2) Total Depth 120 feet.
- (3) Water Level 70' feet below top of ground.
- (4) Cased to 114, Size 2"
- (5) Screen: Size 1/4, Length 4'
below S.S
- (6) Were any formations sealed against pollution?
 yes, no.

If YES depth of formation _____

Why _____

Drillers Remarks: _____

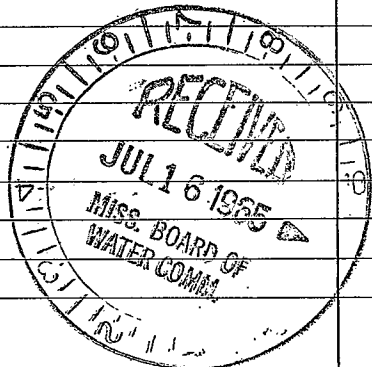

(Use Back Side)

Well No.

