

WAYNE
M 37
7-27-66

MISSISSIPPI BOARD OF WATER COMMISSIONERS

WATER WELL DRILLERS LOG

Date: July 27, 1966, Driller: Porter Drilling & Pump Co., Wayne
(Name)


(1) Owner of Land: Mrs. Nancy Lee Anderson
(Name)
Box 1, Waynesboro, Miss
(Address)
(2) Location: NE 1/4, SE 1/4, Sec. 13 T. 8 R. 8
7 miles west of Waynesboro
(distance) (direction) (Nearest Town)
(3) Topography: Hilly
(Hilly) (Flat) (Level)
(4) Purpose of Well: Chickens
(Domestic Irrigation
Municipal, Industrial, Other)

Description & Color of Materials Sand, Clay, Red Clay, Shell, etc.	Thick- ness Feet	Depth Feet
red clay	18	18
sand	12	30
sand + chalk	22	52
blue chalk	10	62
sand + chalk	43	105
thin rock		105
chalk	21	126
thin rock		126
chalk	4	130
sand + chalk	14	144
chalk	16	160
sand + chalk	13	173
chalk	22	195
course clean sand	23	218
soft course sand + chalk	4	222
clean course, red sand	8	230
soft red sand + chalk	12	242
blue chalk	43	285
rock strata	35	320
blue chalk	2	322
blue sand	3	325
blue chalk	84	409
honeycombed rock		
Nicholson Lignite	23	432
white chalk	10	442

Information upon completion of well:

(1) Diameter 4" inches.
(2) Total Depth 442' feet.
(3) Water Level 188' feet below top of ground.
(4) Cased to 348', Size 4"
348-409 2"
(5) Screen: Size none, Length _____
2" pipe section to 4" with rubber packer
(6) Were any formations sealed against pollution?
_____ yes, X no.

If YES depth of formation _____
Why _____
Drillers Remarks: _____

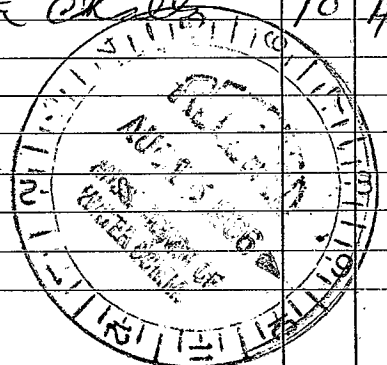

(Use Back Side)

Well No.

10/10/10