

WAYNE

MISSISSIPPI BOARD OF WATER COMMISSIONERS

M38

4-9-62

WATER WELL DRILLERS LOG

Date: April 9, 1962, Driller: Porter Drilling & Pump Co., Inc. County: Wayne

(1) Owner of Land:	Description & Color of Materials Sand, Clay, Red Clay, Shell, etc.	Thick- ness Feet	Depth Feet
Elin C. Hall <small>(Name)</small> Rt 1 Noyesboro, Miss <small>(Address)</small>	wet clay sand - coarse last 12'	25 64	25' 89'
(2) Location: SE 1/4, NW 1/4, Sec. 14 T. 8 R. 8, 6 miles west of Noyesboro <small>(distance) (direction) (Nearest Town)</small>			
(3) Topography: hilly <small>(Hilly) (Flat) (Level)</small>			
(4) Purpose of Well: domestic <small>(Domestic Irrigation Municipal, Industrial, Other)</small>			

Information upon completion of well:


- (1) Diameter 2 inches.
- (2) Total Depth 89 feet.
- (3) Water Level 45 feet below top of ground.
- (4) Cased to 84, Size 2
- (5) Screen: Size 1/4, Length 5' S.S.
- (6) Were any formations sealed against pollution?

yes, X no.

If YES depth of formation

Why

Drillers Remarks:

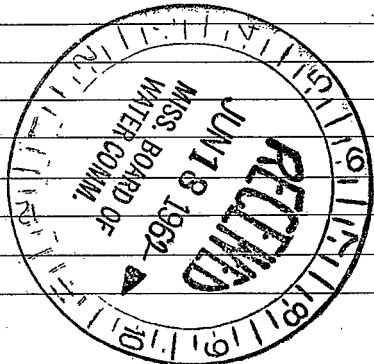

(Use Back Side)

Well No.

