

M39

3-25-61

WATER WELL DRILLERS LOG

M-301

Date: March 25, 1961, Driller: A. N. Porter & Son County Wayne

(Name)

(1) Owner of Land: L. J. Hart
(Name)

Rt 1 Waynesboro, Miss
(Address)

(2) Location: 1/4, 1/4, Sec. 15 T8R2,
7 miles west, of Waynesboro
(distance) (direction) (Nearest Town)

(3) Topography: hilly
(Hilly) (Flat) (Level)

(4) Purpose of Well: domestic
(Domestic Irrigation
Municipal, Industrial, Other)

Description & Color of Materials Sand, Clay, Red Clay, Shell, etc.	Thick- ness Feet	Depth Feet
<u>Clay</u>	<u>20</u>	<u>20'</u>
<u>sand with streaks of chert</u>	<u>52</u>	<u>72'</u>

Information upon completion of well:

(1) Diameter 2" inches.

(2) Total Depth 72' feet.

(3) Water Level 34' feet below top of ground.

(4) Cased to 66', Size 2"


(5) Screen: Size 1 1/4", Length 6'

(6) Were any formations sealed against pollution?
yes, X no.

If YES depth of formation _____

Why _____

Drillers Remarks: _____

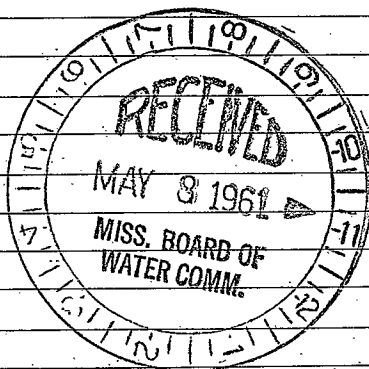

(Use Back Side)

Well No.

