

Wayne
 M 40
 1-68
 30

MISSISSIPPI
 BOARD OF WATER COMMISSIONERS
 416 North State Street
 Jackson, Mississippi 39201

WATER WELL DRILLERS LOG

1-5 1968 Roy W W St Watson & Drilling Wayne
 date well completed firm name county well located

LANDOWNER: Lowe Shirley
Rt 6
Waynesboro
 (mailing address)

description of formations encountered	from	to
clay	0	10
sandy clay	10	40
clay	40	70
sand	70	99

WELL LOCATION:
 sec 2 T 8 N R 8 E
20 miles S.E. of Faulk
 (distance) (direction) (nearest town)

WELL PURPOSE: home
 (home, irrigation, municipal, industrial)

- WELL COMPLETION DATA:
- (1) diameter (inches) 2 in
 - (2) total depth (feet) 99 ft
 - (3) static water level (feet) 30 ^{below}/_{above} top of ground.
 - (4) casing plastic, 94
 (material) (depth)
 _____ if telescope see back.
 (size)
 - (5) screen 5 ft, 94
 (length) (depth to top)
1 1/2, stainless steel
 (size) (material)
 - (6) pump 1/2, 6
 (HP) (yield gpm)
R-E-A
 (type power)
 - (7) electric log _____
 (yes or no)


 (organization running log)
 - (8) how well bottom plugged washed

DRILLERS REMARKS:



If well telescopes please sketch and show depths.

GROUND LEVEL

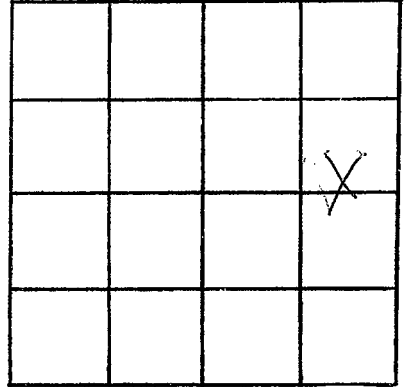

SECTION 20

Please indicate well location X.

ADDITIONAL INFORMATION

If more than one screen,
show locations of each on sketch.