

WAYNE MISSISSIPPI BOARD OF WATER COMMISSIONERS

MA ✓  
8-7-62

WATER WELL DRILLERS LOG

Date: Aug 7, 1962, Driller Dexter Drilling & Pipe County Wayne  
3P (Name)

(1) Owner of Land:	Description & Color of Materials Sand, Clay, Red Clay, Shell, etc.	Thick- ness- Feet	Depth Feet
<u>L. J. Mc Michael</u> (Name)	<u>red clay</u>	<u>10</u>	<u>10</u>
<u>Rt 1 Waynesboro, Miss</u> (Address)	<u>white chalky</u>	<u>40</u>	<u>50</u>
(2) Location: <u>SW 1/4, SE 1/4, Sec 22 T8R8</u>	<u>sand &amp; chalk</u>	<u>22</u>	<u>72</u>
<u>9</u> miles <u>west</u> of <u>Waynesboro</u> (distance) (direction) (Nearest Town)	<u>white chalk</u>	<u>6</u>	<u>78</u>
(3) Topography: <u>hilly</u> (Hilly) (Flat) (Level)	<u>course sand &amp; pea</u>	<u>10</u>	<u>88</u>
(4) Purpose of Well: <u>domestic</u> (Domestic Irrigation Municipal, Industrial, Other)	<u>gravel</u>		

Information upon completion of well:


- (1) Diameter 2" inches.
- (2) Total Depth 88 feet.
- (3) Water Level 62 feet below top of ground.
- (4) Cased to 80, Size 2"
- (5) Screen: Size 1 1/4, Length 5'  
S.S.
- (6) Were any formations sealed against pollution?

yes,  no.

If YES depth of formation \_\_\_\_\_

Why \_\_\_\_\_

Drillers Remarks: \_\_\_\_\_

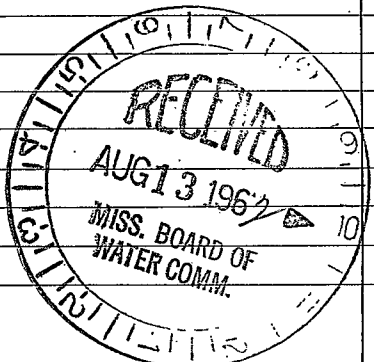

(Use Back Side)

Well No.

