

M43

2-23-63

WATER WELL DRILLERS LOG

Date Feb 23, 1963, Driller Porter Drilling & Log Co. County Wayne  
3P (Name)

(1) Owner of Land: Joel Busby  
(Name)  
Rt 1 Haynesboro, Miss  
(Address)

(2) Location: NW 1/4, SE 1/4, Sec. 23, T8, R8,  
7 miles west of Haynesboro  
(distance) (direction) (Nearest Town)

(3) Topography: hilly  
(Hilly) (Flat) (Level)

(4) Purpose of Well: domestic  
(Domestic Irrigation  
Municipal, Industrial, Other)

Description & Color of Materials Sand, Clay, Red Clay, Shell, etc.	Thick- ness Feet	Depth Feet
<u>red clay</u>	<u>25</u>	<u>25</u>
<u>sand &amp; shells</u>	<u>60</u>	<u>85</u>
<u>sand</u>	<u>25</u>	<u>110'</u>
<u>stagnant white stuff</u> <u>in sand</u>		

Information upon completion of well:

(1) Diameter 2" inches.


(2) Total Depth 110' feet.

(3) Water Level 60' feet below top of ground.

(4) Cased to 105', Size 2"

(5) Screen: Size 1/4", Length 5'  
S.S. Johnson

(6) Were any formations sealed against pollution?  
no

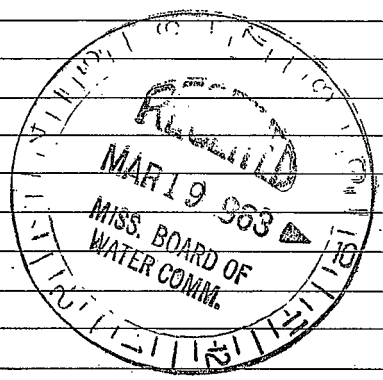

If YES depth of formation \_\_\_\_\_

Why \_\_\_\_\_

Drillers Remarks: \_\_\_\_\_

Well No.

(Use Back Side)

