

WAYNE MISSISSIPPI BOARD OF WATER COMMISSIONERS

M 45

7-24-64

WATER WELL DRILLERS LOG

Date: July 24, 1964, Driller: Coaster Drilling Co. County: Wayne
 3P (Name)

(1) Owner of Land: Newton Busby
 (Name)
Rt 1 Haynesboro
 (Address)

(2) Location: NE 1/4, NW 1/4, Sec 23 T8R8
9 miles S.W. of Haynesboro
 (distance) (direction) (Nearest Town)

(3) Topography: hilly
 (Hilly) (Flat) (Level)

(4) Purpose of Well: domestic
 (Domestic Irrigation
 Municipal, Industrial, Other)

Description & Color of Materials Sand, Clay, Red Clay, Shell, etc.	Thick- ness Feet	Depth Feet
red clay	5	5
chalk	10	15
sand	20	35
chalk	23	58
sand & pea gravel	14	72
chalk	22	94
sand	16	110
stagnant water still in sand		

Information upon completion of well:

(1) Diameter 2" inches.

(2) Total Depth 110' feet.

(3) Water Level 68' feet below top of ground.

(4) Cased to 105', Size 2"


(5) Screen: Size 1/4", Length 5'
Johnson S.S.

(6) Were any formations sealed against pollution?
 yes, no.

If YES depth of formation _____

Why _____

Drillers Remarks: _____

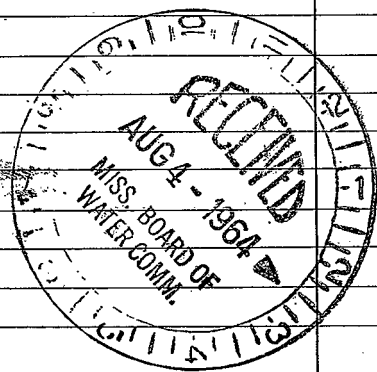

(Use Back Side)

Well No.

