

WAYNE

MISSISSIPPI BOARD OF WATER COMMISSIONERS

M46

12-22-64

WATER WELL DRILLERS LOG

Date: Dec 22, 1964; Driller: Porter Drilling Co., Wayne

(Name)

(1) Owner of Land: Merlin Bond (Name)

At 1 Waynesboro, Miss (Address)

(2) Location: SW 1/4, NW 1/4, Sec. 23 T. 8 R. 8

10 miles west of Waynesboro (distance) (direction) (Nearest Town)

(3) Topography: hilly (Hilly) (Flat) (Level)

(4) Purpose of Well: domestic (Domestic Irrigation Municipal, Industrial, Other)

Description & Color of Materials Sand, Clay, Red Clay, Shell, etc.	Thick- ness Feet	Depth Feet
red clay	5	5
chalk to sand	25	30
sand to pea gravel would not produce	22	52
fine sand	6	58
med to coarse sand	14	72
fine sand	4	76
streak of chalk	6	82
fine sand	9	91
stopped while still in sand		

Information upon completion of well:

(1) Diameter 2" inches.

(2) Total Depth 91' feet.

(3) Water Level 29' feet below top of ground.

(4) Cased to 84', Size 2"

(5) Screen: Size 1 1/4", Length 6' 60 ga


(6) Were any formations sealed against pollution?

yes, X no.

If YES depth of formation

Why

Drillers Remarks:

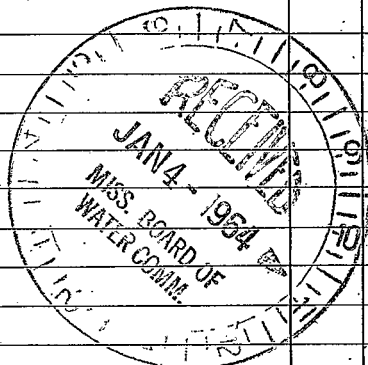

(Use Back Side)

Well No.

