

WAYNE MISSISSIPPI BOARD OF WATER COMMISSIONERS

M 47

7-29-65

WATER WELL DRILLERS LOG

Date: July 29, 1965, Driller: Porter Drilling & Exp. Co., Inc. County: Wayne


(1) Owner of Land: J. M. Malone (Name)
243 Waynesboro Miss (Address)
(2) Location: NW 1/4, SE 1/4, Sec. 24 T8 R8, (distance) 6 miles SW, Waynesboro (Nearest Town)
(3) Topography: hilly (Hilly) (Flat) (Level)
(4) Purpose of Well: domestic (Domestic Irrigation Municipal, Industrial, Other)

Table with columns: Description & Color of Materials, Thickness Feet, Depth Feet. Entries include red clay (15' thickness, 15' depth), sand & silt (46' thickness, 61' depth), stopped on chalk.

Information upon completion of well:

(1) Diameter 2 inches.
(2) Total Depth 61 feet.
(3) Water Level 27 feet below top of ground.
(4) Cased to 56 feet, Size 2 inches.
(5) Screen: Size 1/4 inch, Length 5 feet.
10 slot Johnson S.S.
(6) Were any formations sealed against pollution?
yes, X no.

If YES depth of formation
Why
Drillers Remarks:

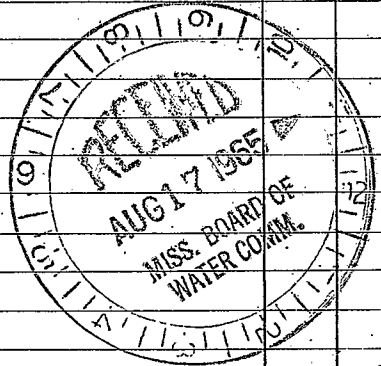

(Use Back Side)

Well No.

