

WAYNE  
M49

MISSISSIPPI BOARD OF WATER COMMISSIONERS

7-5-66 30

WATER WELL DRILLERS LOG

Date: July 5, 1966, Driller: Porter Drilling & Pump Co., Wayne County, Miss.

(1) Owner of Land: Hestley Stevens  
(Name)  
Rt 1 Waynesboro, Miss.  
(Address)

(2) Location: SE 1/4, SW 1/4, Sec 33 T 8 R 8  
7 miles west of Clava  
(distance) (direction) (Nearest Town)

(3) Topography: flat  
(Hilly) (Flat) (Level)

(4) Purpose of Well: domestic  
(Domestic Irrigation  
Municipal, Industrial, Other)

Description & Color of Materials Sand, Clay, Red Clay, Shell, etc.	Thick- ness Feet	Depth Feet
<u>red clay</u>	<u>8</u>	<u>8</u>
<u>chalk</u>	<u>22</u>	<u>30</u>
<u>sand &amp; chalk</u>	<u>12</u>	<u>42</u>
<u>chuck</u>	<u>24</u>	<u>66</u>
<u>sand &amp; peagone</u>	<u>2</u>	<u>68</u>
<u>coarse sand</u>	<u>16</u>	<u>84</u>
<u>sand &amp; chalk</u>	<u>4</u>	<u>88</u>
<u>clean fine sand</u>	<u>5</u>	<u>93</u>
<u>stagnant white</u>		
<u>still in sand</u>		

Information upon completion of well:

(1) Diameter 2" inches.

(2) Total Depth 93 feet.

(3) Water Level 51 feet below top of ground.

(4) Cased to 84, Size 2"


(5) Screen: Size 1 1/4, Length 5'  
Johnson S.S 6 slot

(6) Were any formations sealed against pollution?  
no

If YES depth of formation \_\_\_\_\_

Why \_\_\_\_\_

Drillers Remarks: \_\_\_\_\_

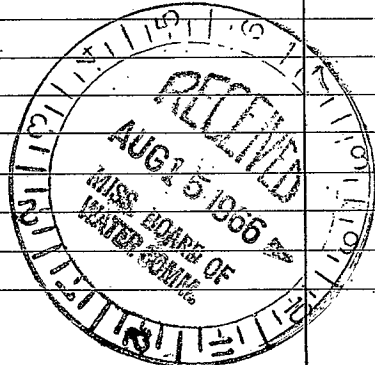

(Use Back Side)

Well No.

