

Wayne
M52
2-68

MISSISSIPPI
BOARD OF WATER COMMISSIONERS
416 North State Street
Jackson, Mississippi 39201

WATER WELL DRILLERS LOG

Feb. 15, 1968 Porter Drilling Co. Wayne
date well completed firm name county well located

LANDOWNER: Grady Miller
Rt 1 Waynesboro, Miss
(mailing address)

description of formations encountered	from	to
Clay	0	20
Chalk	20	40
sand & chalk	40	64
med course red sand	64	72
Chalk & sand	72	83
med course sand	83	96
stagnant on chalk		

WELL LOCATION:
sec 22 T 8 (N) R 8 (E)
9 miles west of Waynesboro
(distance) (direction) (nearest town)

WELL PURPOSE:
(home, irrigation, municipal, industrial)

WELL COMPLETION DATA:

(1) diameter (inches) 2"

(2) total depth (feet) 96'

(3) static water level (feet) 54' below above top of ground.

(4) casing steel 86'
(material) (depth)

2" if telescope see back.
(size)

(5) screen 5' 91'
(length) (depth to top)

1/4 Johnson 2 shot S.S.
(size) (material)

(6) pump 1 8
(HP) (yield gpm)


elec
(type power)

(7) electric log no
(yes or no)

(organization running log)

(8) how well bottom plugged:
flush screen

DRILLERS REMARKS:

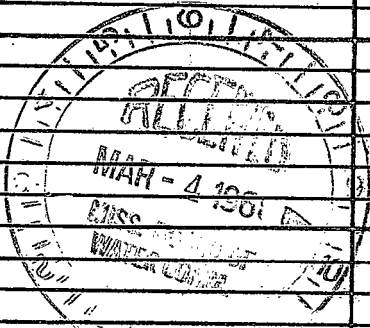

If well telescopes please sketch and show depths.

GROUND LEVEL

X			

SECTION 22

Please indicate well location X.

ADDITIONAL INFORMATION

If more than one screen, show locations of each on sketch.