

WAYNE
M53
-68

MISSISSIPPI
BOARD OF WATER COMMISSIONERS
416 North State Street
Jackson, Mississippi 39201

WATER WELL DRILLERS LOG

date well completed 1968 Ray V. West firm name Wayne county well located

LANDOWNER: James Pitts
Rt 1
Waynesboro Miss
(mailing address)

description of formations encountered

from to

Clay 0 20
Southly Clay 20 60
Sand 60 110

WELL LOCATION:

sec. 3 T. 8 N. R. 8 E
S W
10 miles W of Waynesboro
(distance) (direction) (nearest town)


WELL PURPOSE: home
(home, irrigation, municipal, industrial)

WELL COMPLETION DATA:

- (1) diameter (inches) 2 in
- (2) total depth (feet) 111
- (3) static water level (feet) 60 below above top of ground.
- (4) casing galv 105
(material) (depth)
 if telescope see back.
(size)
- (5) screen 6 105
(length) (depth to top)
1 1/2 Brass gauze
(size) (material)
- (6) pump 1/2 3
(HP) (yield gpm)
R.E.A
(type power)
- (7) electric log No
(yes or no)

(organization running log)
- (8) how well bottom plugged washade

DRILLERS REMARKS:

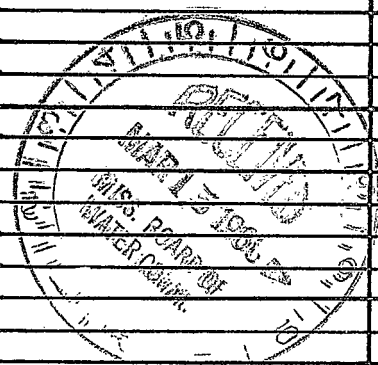

If well telescopes please sketch and show depths.

GROUND LEVEL

			X

SECTION 3

Please indicate well location X.

ADDITIONAL INFORMATION

If more than one screen, show locations of each on sketch.