

Wayne
 M56
 7-68

MISSISSIPPI
 BOARD OF WATER COMMISSIONERS
 416 North State Street
 Jackson, Mississippi 39201

WATER WELL DRILLERS LOG

Wayne
 Jones

7-11 1968 Roy V West firm name
 date well completed county well located


LANDOWNER: Early Pittas
 Rt 1
 Waynesboro
 (mailing address)

description of formations encountered	from	to
	Clay	0
Sandy clay	10	40
Clay	40	85
Sand	85	105

WELL LOCATION:
 sec. 9 T 8 N R 8 E
 15 miles East of Jourd
 (distance) (direction) (nearest town)

WELL PURPOSE: home
 (home, irrigation, municipal, industrial)


- WELL COMPLETION DATA:
- (1) diameter (inches) 2 in
 - (2) total depth (feet) 105
 - (3) static water level (feet) 72 below above top of ground.
 - (4) casing plastic, 100 (material) (depth)
 (size) if telescope see back.
 - (5) screen 5 ft, 100 (length) (depth to top)
 1/4 in, 1/2 Steel (size) (material)
 - (6) pump none (HP) (yield gpm)
 (type power)
 - (7) electric log no (yes or no)
 (organization running log)
 - (8) how well bottom plugged Washwater

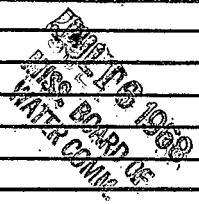

DRILLERS REMARKS:

If well telescopes please sketch and show depths.

GROUND LEVEL

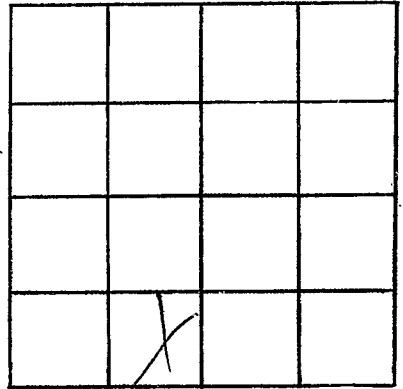

SECTION 9

Please indicate well location X.

ADDITIONAL INFORMATION

If more than one screen,
show locations of each on sketch.