

Wayne
 M 57
 6-68

MISSISSIPPI
 BOARD OF WATER COMMISSIONERS
 416 North State Street
 Jackson, Mississippi 39201

WATER WELL DRILLERS LOG

June 25, 1968 date well completed
 Porter Drilling & Log firm name
 Wayne county well located

LANDOWNER:
 Shocomb Giles
 Rt 3 Waynesboro Miss (mailing address)


description of formations encountered	from	to
red clay	0	10
fine light sand	10	42
small coarse sand	42	45
thin rock		45
chack	45	46

WELL LOCATION:
 sec. 24 T 8 N R 8 E
 6 miles SW of Waynesboro
 (distance) (direction) (nearest town)

WELL PURPOSE: home
 (home, irrigation, municipal, industrial)


- WELL COMPLETION DATA:
- (1) diameter (inches) 2"
 - (2) total depth (feet) 45'
 - (3) static water level (feet) 29 ^{below}/_{above} top of ground.
 - (4) casing steel 40' (material) (depth)
 2" (size) if telescope see back.
 - (5) screen 5' 40' (length) (depth to top)
 1/4 Galot Johnson S.S. (size) (material)
 - (6) pump 3/4 4 (HP) (yield gpm)
 elec (type power)
 - (7) electric log no (yes or no)
 (organization running log)
 - (8) how well bottom plugged
 flush point

DRILLERS REMARKS:
 screen screwed on casing
 & sand packed

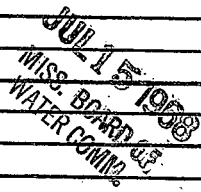

If well telescopes please sketch and show depths.

GROUND LEVEL

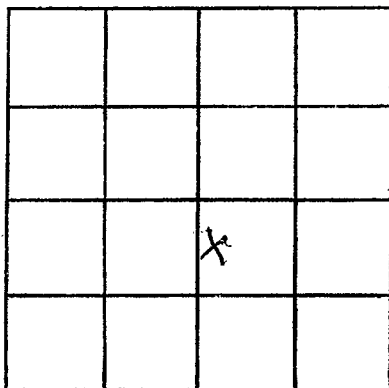

SECTION 24

Please indicate well location X.

ADDITIONAL INFORMATION

If more than one screen, show locations of each on sketch.