

Wayne  
 M 58  
 6-68

MISSISSIPPI  
 BOARD OF WATER COMMISSIONERS  
 416 North State Street  
 Jackson, Mississippi 39201

WATER WELL DRILLERS LOG

June 20, 1968 Porter Drilling, Inc. Wayne  
 date well completed firm name county well located

LANDOWNER: Glenn Landron  
Attn: Waynesboro, Miss  
 (mailing address)

description of formations encountered	from	to
red clay	0	10
sand + chalk	10	40
pea gravel	40	43
chalk	43	48
course sand with red streaks	48	70
med clean sand	70	76
slight white shell in sand but getting finer		


WELL LOCATION:  
 sec. 22 T. 8 (N) R. 8 E  
9 miles west of Waynesboro  
 (distance) (direction) (nearest town)

WELL PURPOSE: home  
 (home, irrigation, municipal, industrial)

WELL COMPLETION DATA:

- (1) diameter (inches) 2"
- (2) total depth (feet) 76'
- (3) static water level (feet) 38' below top of ground.
- (4) casing steel, 61'  
 (material) (depth)  
2" if telescope see back, (size)
- (5) screen 5', 71'  
 (length) (depth to top)  
1/4" 8 slot Johnson S. S.  
 (size) (material)
- (6) pump 4, 8  
 (HP) (yield gpm)  
elec  
 (type power)
- (7) electric log no  
 (yes or no)  
 (organization running log)
- (8) how well bottom plugged flush point


10' 1/4" log pipe on screen  
test in with packer

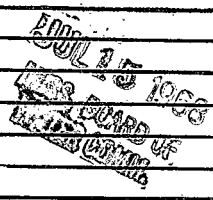

DRILLERS REMARKS:

If well telescopes please sketch and show depths.

GROUND LEVEL

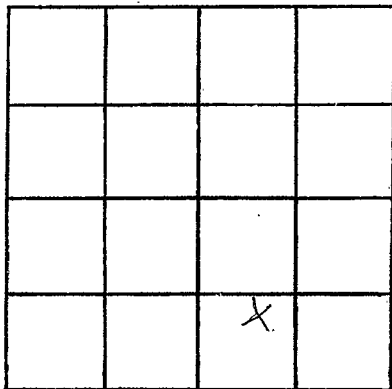

SECTION 22

Please indicate well location X.

ADDITIONAL INFORMATION

If more than one screen,  
show locations of each on sketch.