

CODED

MISSISSIPPI  
BOARD OF WATER COMMISSIONERS  
416 North State Street  
Jackson, Mississippi 39201

WATER WELL DRILLERS LOG

Wayne  
M 59  
5-68

520 1968 Roy V. West Wayne  
date well completed firm name county well located

LANDOWNER: Trinity Baptist  
Church Rt #1  
Waynesboro  
(mailing address)

description of formations encountered	from	to
clay	0	10
sandy clay	10	40
sand	40	82

WELL LOCATION:  
sec. 4 T 8 N R 8 E  
S W  
14 miles W of Waynesboro  
(distance) (direction) (nearest town)

WELL PURPOSE: Church use  
(home, irrigation, municipal, industrial)

WELL COMPLETION DATA:


- (1) diameter (inches) 2 1/2
- (2) total depth (feet) 82
- (3) static water level (feet) 30 below top of ground.
- (4) casing plastic, 37 (material) (depth)
- (size) If telescope see back.
- (5) screen 5 ft, 77 (length) (depth to top)
- 1 1/4 St Steel (size) (material)
- (6) pump 1/2 6 (HP) (yield gpm)
- Rea (type power)
- (7) electric log NO (yes or no)
- (organization running log)
- (8) how well bottom plugged Wash water

DRILLERS REMARKS:

JUN 10 1968  
MISS. BPA CO  
WATER COMMISSION

If well telescopes please sketch and show depths.

GROUND LEVEL

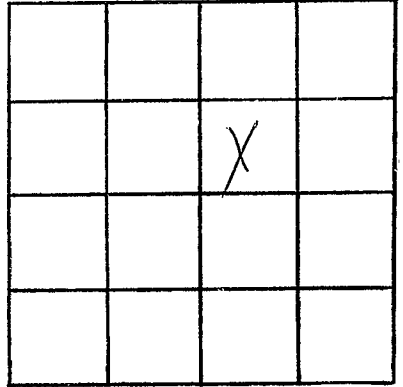

SECTION 8

Please indicate well location X.

ADDITIONAL INFORMATION

If more than one screen, show locations of each on sketch.