

Wayne
M 60
7-68

MISSISSIPPI
BOARD OF WATER COMMISSIONERS
416 North State Street
Jackson, Mississippi 39201

CODED

WATER WELL DRILLERS LOG

7.29 1968 Ray West Wayne
date well completed firm name county well located

LANDOWNER: Mrs Dempsey
Rt 1 Waynesboro
(mailing address)

Description of formations encountered	from	to
Clay	0	8
sandy clay	8	35
Clay	35	110
sand	110	150

WELL LOCATION:
sec. 1 T. 8 N. R. 8 E
8 miles W of Waynesboro
(distance) (direction) (nearest town)

WELL PURPOSE: home
(home, irrigation, municipal, industrial)


WELL COMPLETION DATA:

- (1) diameter (inches) 2 in
- (2) total depth (feet) 150
- (3) static water level (feet) 60 below above top of ground.
- (4) casing Galv, 144,
(material) (depth)
 if telescope see back.
(size)
- (5) screen 6, 144
(length) (depth to top)
1 1/2, Stl Steel
(size) (material)
- (6) pump horse 7
(HP) (yield gpm)
R.E.A
(type power)
- (7) electric log No
(yes or no)

(organization running log)

(8) how well bottom plugged wash hole

DRILLERS REMARKS:

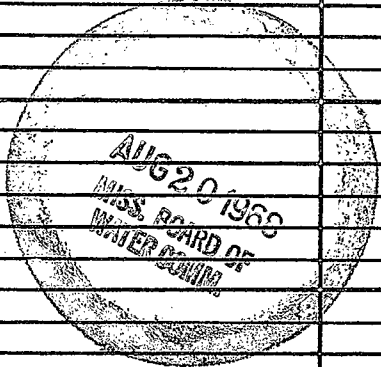

If well telescopes please sketch and show depths.

GROUND LEVEL

			X

SECTION 1

Please indicate well location X.

ADDITIONAL INFORMATION

If more than one screen,
show locations of each on sketch.