

Wayne
 M 61
 10-23-68

MISSISSIPPI
 BOARD OF WATER COMMISSIONERS
 416 North State Street
 Jackson, Mississippi 39201

CODED

WATER WELL DRILLERS LOG

10 23 1968 Ray V West Wayne
 date well completed firm name county well located

LANDOWNER: Henry Rawson
RT 1
Box 150 Waynesboro
 (mailing address)

| description of fomations encountered | from | to |
|--------------------------------------|------|----|
| clay | 0 | 10 |
| sandy clay | 10 | 35 |
| clay | 35 | 60 |
| sandy clay | 60 | 73 |
| sand | 73 | 73 |

WELL LOCATION:
 sec. 5 T. 8 N. R. 8 E
15 miles E of Laurel
 (distance) (direction) (nearest town)

WELL PURPOSE: home
 (home, irrigation, municipal, industrial)

WELL COMPLETION DATA:

(1) diameter (inches) 2

(2) total depth (feet) 93

(3) static water level (feet) 35 below top of ground.

(4) casing plastic, 88
 (material) (depth)
 (size) if telescope see back.


(5) screen 5, 88
 (length) (depth to top)
1/4, St Steel
 (size) (material)

(6) pump 1, 8
 (HP) (yield gpm)
Rea
 (type power)

(7) electric log No
 (yes or no)
 (organization running log)

(8) how well bottom plugged wash valve


CODED

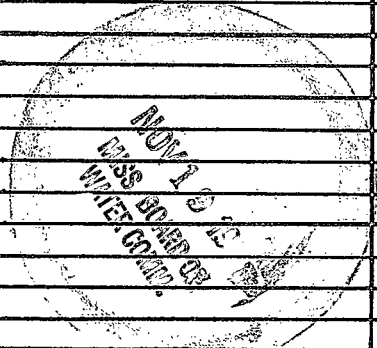

DRILLERS REMARKS:

If well telescopes please sketch and show depths.

GROUND LEVEL

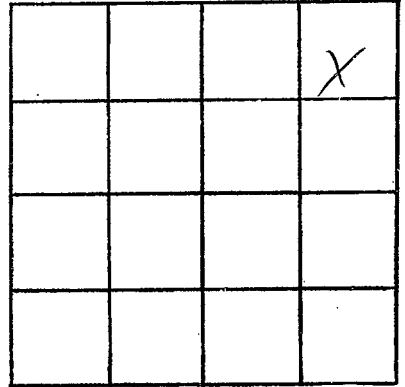

SECTION 5th

Please indicate well location X.

ADDITIONAL INFORMATION

If more than one screen,
show locations of each on sketch.