

MISSISSIPPI  
BOARD OF WATER COMMISSIONERS  
416 North State Street  
Jackson, Mississippi 39201


CODED

WATER WELL DRILLERS LOG

Wayne  
M 62  
9-68


Sept 3 19 68 Boyle Drilling Co. Wayne  
date/well completed firm name county well located

LANDOWNER: <u>Hal Brown Webb</u>	description of formations encountered	from	to
<u>211 Wagonwheel Miss</u> (mailing address)	<u>red clay</u> <u>1st black</u> <u>city. 1st gravel</u>	<u>0</u> <u>2</u>	<u>2</u> <u>58</u>
WELL LOCATION: sec. <u>4</u> T. <u>20</u> N. R. <u>2</u> E. <u>8</u> miles <u>west</u> of <u>Waynesboro</u> (distance) (direction) (nearest town)			
WELL PURPOSE: <u>Home</u> (home, irrigation, municipal, industrial)	<u>1 1/2' long on screen</u> <u>strip with gravel</u>		
WELL COMPLETION DATA:			
(1) diameter (inches) <u>2'</u>	<u>1 1/2" down pipe</u> <u>CODED</u>		
(2) total depth (feet) <u>58'</u>			
(3) static water level (feet) <u>33'</u> <u>below</u> top of ground.			
(4) casing <u>steel</u> , <u>52'</u> (material) (depth) <u>2'</u> if telescope see back. (size)			
(5) screen <u>6'</u> , <u>52'</u> (length) (depth to top) <u>1 1/2"</u> , <u>30m bronze packed</u> (size) (material)			
(6) pump <u>1/2</u> <u>2</u> (HP) (yield gpm) <u>elec.</u> (type power)			
(7) electric log <u>no</u> (yes or no) <u>(organization running log)</u>			
(8) how well bottom plugged: <u>blow ground</u>			
DRILLERS REMARKS:			

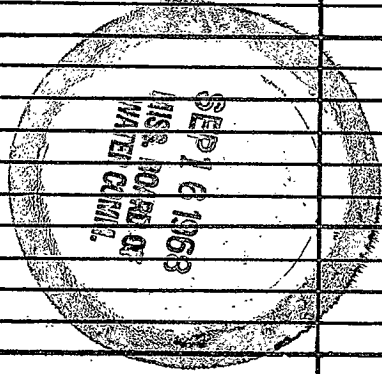

If well telescopes please sketch and show depths.

GROUND LEVEL

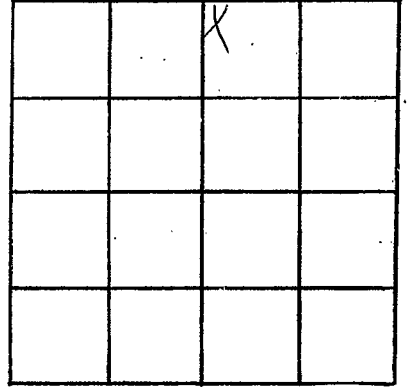

SECTION 4

Please indicate well location X.

ADDITIONAL INFORMATION

If more than one screen,  
show locations of each on sketch.