

Wayne  
 63  
 12-9-68  
 129

MISSISSIPPI  
 BOARD OF WATER COMMISSIONERS  
 416 North State Street  
 Jackson, Mississippi 39201

INDEXED

WATER WELL DRILLERS LOG

1968 Roy West Wayne  
 date well completed firm name county well located

LANDOWNER: Buck Davis  
 Rt 1  
 Waynesboro Miss  
 (mailing address)

description of formations encountered	from	to
Clay	0	10
Sandy clay	10	35
Clay	35	80
Sand	80	101

WELL LOCATION:  
 sec. 14 T. 8 N. R. 8 E  
 S W  
 10 miles W of Waynesboro  
 (distance) (direction) (nearest town)

INDEXED

WELL PURPOSE: home  
 (home, irrigation, municipal, industrial)

- WELL COMPLETION DATA:
- (1) diameter (inches) 2
  - (2) total depth (feet) 101
  - (3) static water level (feet) 48 below top of ground.
  - (4) casing galv 96 (material) (depth)
  - (size) If telescope see back.
  - (5) screen 5 96 (length) (depth to top)
  - 1 1/4 St steel (size) (material)
  - (6) pump 1/2 3 (HP) (yield gpm)
  - Rea (type power)
  - (7) electric log no (yes or no)

(organization running log)

JAN - 9 1968


(8) how well bottom plugged washed

MISS. DEPT. OF WATER CONTROL

DRILLERS REMARKS:

If well telescopes please sketch and show depths.

GROUND LEVEL

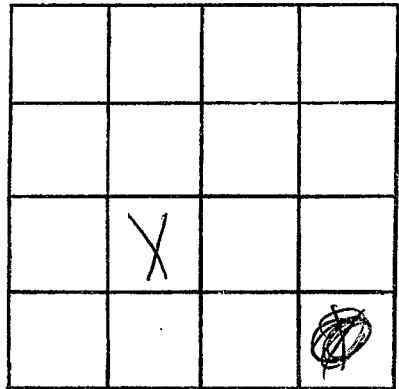

SECTION 14

Please indicate well location X.

ADDITIONAL INFORMATION

If more than one screen,  
show locations of each on sketch.