

MISSISSIPPI
BOARD OF WATER COMMISSIONERS
416 North State Street
Jackson, Mississippi 39201

CODED

WATER WELL DRILLERS LOG

Wayne
M 64
8-68

Aug 27 1968 Boyd Drilling & Pump Wayne
date well completed firm name county well located

LANDOWNER: C. C. Hall

description of formations encountered

from

to

Box 1 Magnolia, Miss
(mailing address)

sand 0 2
sand & shell 2 103
some sand & thin shale

WELL LOCATION:

sec 14 T 8 N 8 E
S W
7 miles W of Hampton
(distance) (direction) (nearest town)

shales 109 115
some sand & thin gravel 115 134
stone & shale still
thin sand & gravel

WELL PURPOSE: home
(home, irrigation, municipal, industrial)

WELL COMPLETION DATA:

(1) diameter (inches) 2"
(2) total depth (feet) 124'
(3) static water level (feet) 30' (below above top of ground)

8 1/2" dia. pipe in cover
section with
94' 1/2" pipe

(4) casing steel 115'
(material) (depth)
2"
(size) if telescope see back.


(5) screen 5' 117'
(length) (depth to top)
1/2" 20 mesh S.S.
(size) (material)

(6) pump 1 6
(HP) (yield gpm)
elec.
(type power)

(7) electric log no
(yes or no)
(organization running log)


(8) how well bottom plugged
flush gravel

DRILLERS REMARKS:

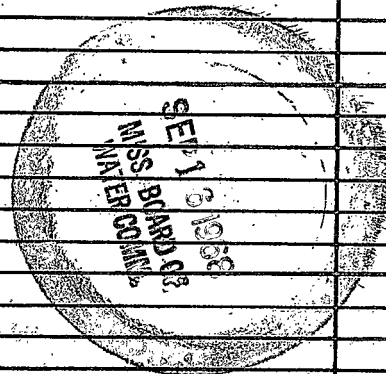

If well telescopes please sketch and show depths.

GROUND LEVEL

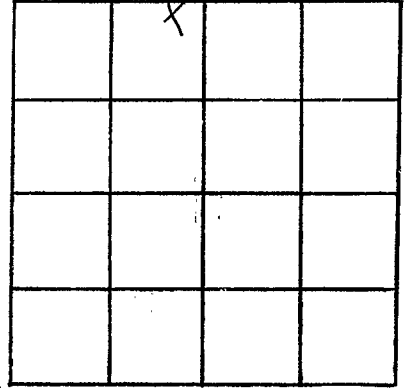

SECTION 14

Please indicate well location X.

ADDITIONAL INFORMATION

If more than one screen,
show locations of each on sketch.