

Wayne
M 67
1-7-69

MISSISSIPPI
BOARD OF WATER COMMISSIONERS
416 North State Street
Jackson, Mississippi 39201

CODED

CODED

WATER WELL DRILLERS LOG

Jan 7 1969 date well completed
Booth Drilling & Log firm name
Wayne county well located

LANDOWNER: Alfred Bunch

description of formations encountered	from	to
---------------------------------------	------	----

Box 3 Waynesboro Miss (mailing address)

red clay	0	8
clay to sand	8	30
chick	20	30

WELL LOCATION:
sec 24 T 8 N R 8 E S W
5 miles SW of Waynesboro (distance) (direction) (nearest town)

moist loam sand	30	38
clean sand to mudstone		
sand	38	55
stagnant, chalky sand		

WELL PURPOSE: Home (home, irrigation, municipal, industrial)

WELL COMPLETION DATA:

3' 1/4" long pipe trail into hole with packer

(1) diameter (inches) 2"

(2) total depth (feet) 55'

(3) static water level (feet) 39' below top of ground.

(4) casing Copper 49' (material) (depth)
2" (size) if telescope see back.

40' 1/4" long pipe

(5) screen 5' 50' (length) (depth to top)

1/4" Galv S.S. Johnson (size) (material)

(6) pump 3/4 8 (HP) (yield gpm)

elec. (type power)

(7) electric log no (yes or no)

(organization running log)

FEB - 3 - 1969


(8) how well bottom plugged -

MISS. BD. OF WATER COMM.

DRILLERS REMARKS:

If well telescopes please sketch and show depths.

GROUND LEVEL

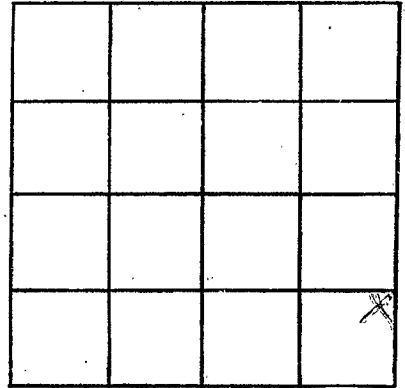

SECTION 24

Please indicate well location X.

ADDITIONAL INFORMATION

If more than one screen, show locations of each on sketch.