

Wayne
M 68
1-13-69

MISSISSIPPI
BOARD OF WATER COMMISSIONERS
416 North State Street
Jackson, Mississippi 39201

CODED

CODED

WATER WELL DRILLERS LOG

Jan 13 1969 date well completed
Robert Drilling & Log firm name
Wayne county well located

LANDOWNER: W. Roberts
Siber
P.O. 321 American Home Min.
(mailing address)

description of formations encountered	from	to
red clay	0	8
sand & silt	8	45
thin rock		45
chalk	45	72
fine sand & some chalk	72	128
chalk	125	220
fine sand & chalk	220	230
streamed coarse sand	230	237
streamed cherty sand		

WELL LOCATION:
sec 24 T. 90 N. R. 2 E.
6 miles (distance) SW (direction) of Waynesboro (nearest town)

WELL PURPOSE: drinking
(home, irrigation, municipal, industrial)

WELL COMPLETION DATA:

(1) diameter (inches) 2"

(2) total depth (feet) 237'

(3) static water level (feet) 83' below/above top of ground.

(4) casing steel 231'
(material) (depth)
2" If telescope see back.
(size)

(5) screen 5' 232'
(length) (depth to top)
1/4" 7' x 5.5'
(size) (material)

(6) pump 1 7
(HP) (yield gpm)
elec
(type power)

(7) electric log no
(yes or no)

(organization running log)

(8) how well bottom plugged blank point


CODED

FEB 7 1969
MISS. REG. DIV.
JACKSON, MISS.

DRILLERS REMARKS:

If well telescopes please sketch and show depths.

GROUND LEVEL

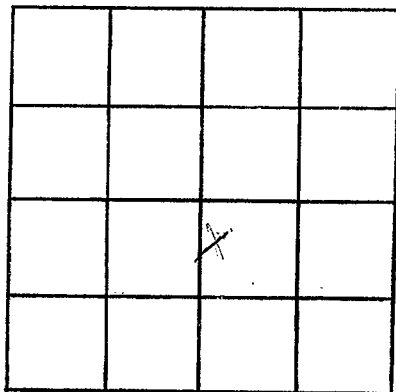

SECTION 24

Please indicate well location X.

ADDITIONAL INFORMATION

If more than one screen, show locations of each on sketch.