

WAYNE  
M69  
3-10-69

MISSISSIPPI  
BOARD OF WATER COMMISSIONERS  
416 North State Street  
Jackson, Mississippi 39201

WATER WELL DRILLERS LOG

May 0 1969 Royl West Wayne  
date well completed firm name county well located

LANDOWNER: <u>Denny McKee</u>	description of formations encountered	from	to
<u>Box 412</u>			
<u>Laurel miss</u> (mailing address)	<u>clay</u>	<u>0</u>	<u>12</u>
	<u>sand</u>	<u>12</u>	<u>35</u>
	<u>sandy clay</u>	<u>35</u>	<u>80</u>
	<u>sand</u>	<u>80</u>	<u>122</u>
WELL LOCATION:			
sec. <u>10</u> T. <u>8</u> N. R. <u>8</u> E			
<u>18</u> miles <u>S</u> of <u>Laurel</u>			
(distance) (direction) (nearest town)			
WELL PURPOSE: <u>home</u> (home, irrigation, municipal, industrial)			
WELL COMPLETION DATA:			
(1) diameter (inches) <u>2</u>			
(2) total depth (feet) <u>122</u>			
(3) static water level (feet) <u>80</u> <u>below</u> above top of ground.			
(4) casing <u>galv</u> <u>117</u> (material) (depth)			
(size) if telescope see back.			
(5) screen <u>5</u> <u>117</u> (length) (depth to top)			
<u>1 1/4</u> <u>st steel</u> (size) (material)			
(6) pump <u>1</u> <u>8</u> (HP) (yield gpm)			
<u>Rea</u> (type power)			
(7) electric log <u>no</u> (yes or no)			
(organization running log)			
(8) how well bottom plugged <u>washed</u>			
DRILLERS REMARKS:			


CODEN

ADD  
APR 3 1969

MISS. BD. OF  
WATER COMMISSIONERS

If well telescopes please sketch and show depths.

GROUND LEVEL

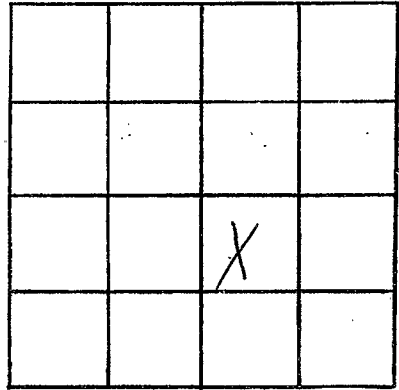

SECTION 10

Please indicate well location X.

ADDITIONAL INFORMATION

If more than one screen,  
show locations of each on sketch.