

Wayne
M 70,
5-20-69

MISSISSIPPI
BOARD OF WATER COMMISSIONERS
416 North State Street
Jackson, Mississippi 39201

WATER WELL DRILLERS LOG

5-20 1969 Key West Wayne
date well completed firm name county well located

LANDOWNER: Tommy Gattlin
Rt 1
Waynesboro
(mailing address)

| description of formations encountered | from | to |
|---------------------------------------|----------|-----|
| | red clay | 0 |
| sandy clay | 8 | 40 |
| clay | 40 | 90 |
| sand | 90 | 120 |

WELL LOCATION:
sec. 3 T 8 N R 8 E
S W
12 miles W of Waynesboro
(distance) (direction) (nearest town)

WELL PURPOSE: home
(home, irrigation, municipal, industrial)

- WELL COMPLETION DATA:
- (1) diameter (inches) 2
 - (2) total depth (feet) 120
 - (3) static water level (feet) 45 below above top of ground.
 - (4) casing galv 115 (material) (depth)
(size) if telescope see back.
 - (5) screen 5 115 (length) (depth to top)
1/4" st steel (size) (material)
 - (6) pump 3/4 5 (HP) (yield gpm)
R&A (type power)
 - (7) electric log 210 (yes or no)
 - (8) how well bottom plugged washwater


JUN 11 1969

MISS. BD. OF
WATER COM.

DRILLERS REMARKS:

If well telescopes please sketch and show depths.

GROUND LEVEL

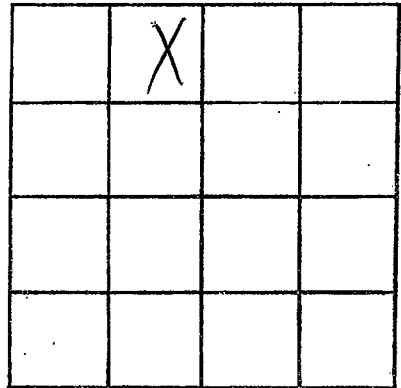

SECTION

3

Please indicate well location X.

ADDITIONAL INFORMATION

If more than one screen,
show locations of each on sketch.