

WAYNE
M 72
7-1-69

MISSISSIPPI
BOARD OF WATER COMMISSIONERS
416 North State Street
Jackson, Mississippi 39201

CODED

WATER WELL DRILLERS LOG


July 1 1969 Route Dally Wayne
date well completed firm name county well located

LANDOWNER: <u>Samuel Douglas</u>	description of formations encountered	from	to
<u>211 Magnolia Miss</u> (mailing address)	<u>sand clay</u>	<u>0</u>	<u>10</u>
	<u>sand & shells</u>	<u>10</u>	<u>62</u>
	<u>sand & clean sand</u>	<u>62</u>	<u>68</u>
	<u>stagnant water level in sand</u>		
WELL LOCATION: sec. <u>4</u> T <u>2</u> N R <u>9</u> E <u>8</u> miles <u>west</u> of <u>Waynesboro</u> (distance) (direction) (nearest town)			
WELL PURPOSE: <u>home</u> (home, irrigation, municipal, industrial)			
WELL COMPLETION DATA:			
(1) diameter (inches) <u>2"</u>	<u>3' 1/2' 3" galvanized iron well</u>		
(2) total depth (feet) <u>68'</u>	<u>2' 1/2' iron pipe in sand</u>		
(3) static water level (feet) <u>72</u> <u>below</u> top of ground.	<u>Cylinder 63' to 64'</u>		
(4) casing <u>steel</u> , <u>65'</u> (material) (depth)			
<u>2"</u> if telescope see back. (size)			
(5) screen <u>3'</u> , <u>65'</u> (length) (depth to top)			
<u>1/2"</u> <u>galv. s.s.</u> (size) (material)			
(6) pump <u>hand</u> , <u>3 1/2'</u> (HP) (yield gpm)			
<u>elec.</u> (type power)			
(7) electric log <u>yes</u> (yes or no)			
(organization running log)			
(8) how well bottom plugged <u>filled with gravel</u>			
DRILLERS REMARKS:			

AUG 15 1969
WELL PERM
MISSISSIPPI

If well telescopes please sketch and show depths.

GROUND LEVEL

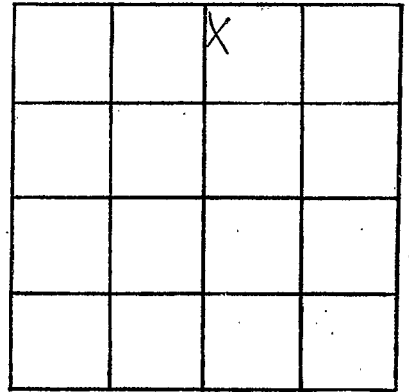

SECTION 4

Please indicate well location X.

ADDITIONAL INFORMATION

If more than one screen, show locations of each on sketch.